

JACKSON
N399
7-5-72

MISSISSIPPI
 BOARD OF WATER COMMISSIONERS
 416 North State Street
 Jackson, Mississippi 39201
WATER WELL DRILLERS LOG

CODED

7-5 1972 Switzer Well Co. Jackson
 date well completed firm name county well located

LANDOWNER: Assembly of God Church
OLD US Hwy 90
Ocean Springs, Miss. 39564
 (mailing address)

WELL LOCATION:
 sec. 14 T. 7 S. R. 9 W.
3 miles NW of Ocean Springs
 (distance) (direction) (nearest town)

WELL PURPOSE: Church
 (home, irrigation, municipal, industrial)

WELL COMPLETION DATA:
 (1) diameter (inches) 8"
 (2) total depth (feet) 470'
 (3) static water level (feet) 39 below above
 top of ground.
 (4) casing galv. 470'
 (material) (depth)
 (size) If telescope see back.
 (5) screen 10' 460'
 (length) (depth to top)
608 stainless steel
 (size) (material)
 (6) pump 1/2 8
 (HP) (yield gpm)
Electric
 (type power)
 (7) electric log no
 (yes or no)
 (organization running log)
 (8) how well bottom plugged leak
pressure valve

description of formations encountered	from	to
clay	0	12
sand-gravel	12	34
blue clay	34	44
sand	44	56
clay	56	65
clay-sandst.	65	108
clay	108	110
sand	110	118
clay	118	124
sand	124	139
clay	139	298
sand	298	260
clay	260	270
sand	270	291
clay	291	339
sand	339	355
clay	355	402
fine sand	402	406
good sand	406	471

CODED


SEP 5 1972

MISS. Bd. of
 WATER COMMISSIONERS

DRILLERS REMARKS:

If well telescopes please sketch and show depths.

GROUND LEVEL

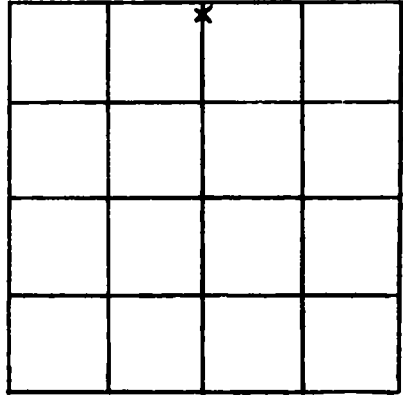

SECTION 14

Please indicate well location X.

ADDITIONAL INFORMATION

If more than one screen,
show locations of each on sketch.