

JACKSON

N 409.

9-25-72

MISSISSIPPI
BOARD OF WATER COMMISSIONERS
416 North State Street
Jackson, Mississippi 39201

WATER WELL DRILLERS LOG

9-25 1972
date well completed

Scitgen Well Co
firm name

Jackson
county well located

LANDOWNER: Milton N. Casie

Cc Road

Ocean Springs, Miss.
(mailing address)

WELL LOCATION:

sec. 22 T. 7 S R. 9 W

1/2 miles NE of Ocean Springs
(distance) (direction) (nearest town)

WELL PURPOSE: home
(home, irrigation, municipal, industrial)

WELL COMPLETION DATA:

- (1) diameter (inches) # 2"
 (2) total depth (feet) 480'
 (3) static water level (feet) 37'9" ^{below}/_{above} top of ground.

(4) casing galv. 480'
(material) (depth)

(size) if telescope see back.

(5) screen 10' 470'
(length) (depth to top)

008 stainless steel
(size) (material)

(6) pump 1 IP
(HP) (yield gpm)

Electric
(type power)

(7) electric log No
(yes or no)

(organization running log)

(8) how well bottom plugged back
Pressure Valve

description of formations encountered

from to

clay 0 21

soft clay 21 41

mixed 41 61

clay 61 81

sand 81 89

clay 89 120

mixed 120 140

clay 140 215

sand 215 220

clay 220 296

sand 296 299

clay 299 437

fine sand 437 457

fine sand 457 477


sand 477 480

DRILLERS REMARKS:

OCT 2 1972

If well telescopes please sketch and show depths.

GROUND LEVEL

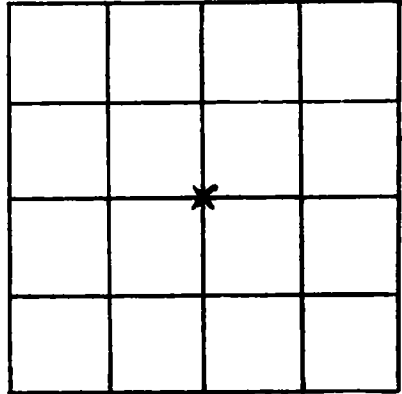

SECTION 27

Please indicate well location X.

ADDITIONAL INFORMATION

If more than one screen, show locations of each on sketch.