

JACKSON
 N 411
 10-3-72

MISSISSIPPI
 BOARD OF WATER COMMISSIONERS
 416 North State Street
 Jackson, Mississippi 39201

WATER WELL DRILLERS LOG

CODED

10-3 1972 date well completed Switzer Well Company firm name JACKSON county well located

| LANDOWNER | description of formations encountered | from | to |
|-------------------------------------------|---------------------------------------|------|-----|
| Gary Blackledge | | | |
| Vandavee Rd., Rt. 4 | Clay | 0 | 98 |
| Ocean Springs, Miss. (mailing address) | Sand | 98 | 100 |
| | Sand, red | 100 | 118 |

WELL LOCATION:
 sec. 13 T. 7 S R. 8 W
 2 miles NE of Ocean Springs
 (distance) (direction) (nearest town)

WELL PURPOSE: Home
 (home, irrigation, municipal, industrial)

- WELL COMPLETION DATA:
- (1) diameter (inches) 2"
 - (2) total depth (feet) 118'
 - (3) static water level (feet) 29' below top of ground.
 - (4) casing galv. 118' (material) (depth)
 - (size) If telescope see back.
 - (5) screen 10' 108' (length) (depth to top)
 - 008, stainless steel (size) (material)
 - (6) pump 1 (HP) 10 (yield gpm)
 - Electric (type power)
 - (7) electric log no (yes or no)
 - (organization running log)
 - (8) how well bottom plugged back
 pressure valve


CODED

NOV 27 1972

DRILLERS REMARKS:

If well telescopes, please sketch and show depths.

GROUND LEVEL

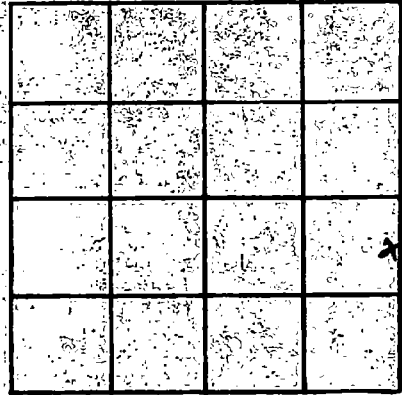

SECTION 13

Please indicate well location X.

ADDITIONAL INFORMATION

If more than one screen, show locations of each on sketch.