

JACKSON
N 412
10-5-72

MISSISSIPPI
 BOARD OF WATER COMMISSIONERS
 416 North State Street
 Jackson, Mississippi 39201
WATER WELL DRILLERS LOG

CODED

10-5 1972 Switzer Well Company JACKSON
 date well completed firm name county well located

LANDOWNER	description of formations encountered	from	to
GULF PARK ESTATES	Sand	0	21
Marina Ave. #17	Soft clay	21	61
Ocean Springs, Miss. 39564	Sand	61	67
(mailing address)	Clay	67	81
WELL LOCATION:	Mixed	81	100
sec 34 T 7 S R 8 W	Clay	100	120
1 1/4 miles E of Ocean Springs	Sand	120	154
(distance) (direction) (nearest town)	Clay	154	210
WELL PURPOSE: <u>Subsidence</u>	Rock	210	211
(home, irrigation, municipal, industrial)	Strata	211	220
WELL COMPLETION DATA:	Clay	220	299
(1) diameter (inches) 2"	Mixed	299	319
(2) total depth (feet) 465'	Clay + shale	319	339
(3) static water level (feet) -27	Clay	339	378
top of ground. (below/above)	Sand	378	379
(4) casing galv. 465'	Clay	379	397
(material) (depth)	Sand	397	398
(size) If telescope see back.	Sand, fine	398	438
(5) screen 10' 455'	Sand, good	438	478
(length) (depth to top)	Sand	478	485
008 stainless steel			
(size) (material)			
(6) pump 1 HP 10 yield gpm			
(HP) (yield gpm)			
ELECTRIC			
(type power)			
(7) electric log NO			
(yes or no)			
(organization running log)			
(8) how well bottom plugged back			
Pressure Valve			
DRILLERS REMARKS:			


CODED

Well set at 465 feet.

NOV 27 1972

If well telescopes please sketch and show depths.

GROUND LEVEL

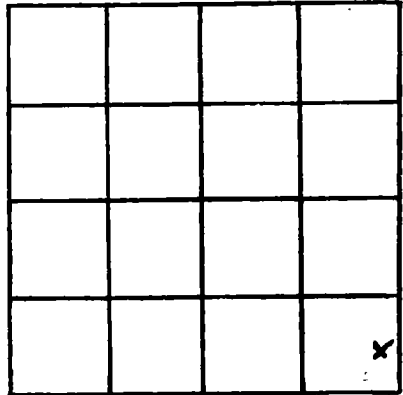

SECTION 34

Please indicate well location X.

ADDITIONAL INFORMATION

If more than one screen, show locations of each on sketch.