

JACKSON
~~Hammond~~
 PN414
 6-14-72

MISSISSIPPI
 BOARD OF WATER COMMISSIONERS
 416 North State Street
 Jackson, Mississippi 39201

WATER WELL DRILLERS LOG
 COASTAL DRILLING & SERVICE CO.

Jackson
~~Hammond~~
 county well located

6/14/72
 date well completed

ROUTE 1 BOX 618

LANDOWNER: H. O. Masley
 Rt 2 Box 46B
 Bibop, Miss
 (mailing address)

description of formations encountered	from	to
top soil	1	3
Red Clay	3	11
Red Sand	11	23
White Sand	23	44
Flume	44	46
fine water sand	46	65
Red Blue Clay	65	210
Dark Blue Clay	210	630
fine water sand	630	645
fine water sand	645	670
Dark Blue Clay	670	740
fine water sand	740	760
fine water sand	760	814

WELL LOCATION:
 sec. 3 T 7 N R 9 E
2 miles N of Bibop
 (distance) (direction) (nearest town)

WELL PURPOSE:
 (home, irrigation, municipal, industrial)

WELL COMPLETION DATA:

- (1) diameter (inches) 2"
- (2) total depth (feet) 814'
- (3) static water level (feet) 21' below above top of ground.
- (4) casing Galv 804'
 (material) (depth)
- _____ If telescope see back.
 (size)
- (5) screen 10' 804'
 (length) (depth to top)
- 2" S.S.
 (size) (material)
- (6) pump one 16
 (HP) (yield gpm)
- Elc
 (type power)
- (7) electric log no
 (yes or no)

(organization running log)


(8) how well bottom plugged
2" back with water

DRILLERS REMARKS:
none

NOV 17 1972

If well telescopes please
sketch and show depths.

GROUND LEVEL

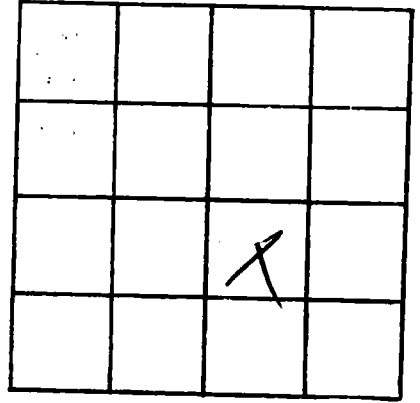

SECTION _____

Please indicate well location X.

ADDITIONAL INFORMATION

If more than one screen,
show locations of each on sketch.