

JACKSON
N 415
7-10-72

MISSISSIPPI
BOARD OF WATER COMMISSIONERS
416 North State Street
Jackson, Mississippi 39201

WATER WELL DRILLERS LOG

7/10/72 date well completed
COASTAL DRILLING & SERVICE CO. firm name
ROUTE 1 BOX 618 county well located

LANDOWNER: M.F. Jackson
Rt 5 Box
Ocean Springs, Miss
(mailing address)

WELL LOCATION:
sec 2 T 1 N R 9 E
3 miles N Ocean Springs
(distance) (direction) (nearest town)

WELL PURPOSE: home
(home, irrigation, municipal, industrial)


WELL COMPLETION DATA:
(1) diameter (inches) 2"
(2) total depth (feet) 418'
(3) static water level (feet) 38' below top of ground
(4) casing (material) galv (depth) 408'
(5) screen (size) 10' (length) 408' (depth to top) SS 2" (material)
(6) pump One (HP) 16 (yield gpm) Cle (type power)
(7) electric log 710 (yes or no)
(organization running log)

description of formations encountered	from	to
top soil	1	2
Red Clay	2	7
Brown Swill	7	10
Red Sand	10	17
White Sand	17	42
Soft Blue Clay	42	205
Hard Blue Clay	205	355
fine water sand	355	375
Coarse water sand	375	408

(8) how well bottom plugged
2" sand wash water
DRILLERS REMARKS:
None

If well telescopes please sketch and show depths.

GROUND LEVEL

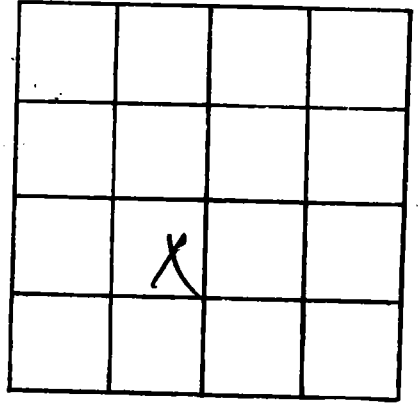

SECTION _____

Please indicate well location X.

ADDITIONAL INFORMATION

If more than one screen, show locations of each on sketch.