

JACKSON
N 416
11-19-72

MISSISSIPPI
BOARD OF WATER COMMISSIONERS
416 North State Street
Jackson, Mississippi 39201

CODED

WATER WELL DRILLERS LOG

11-19-1972 date well completed
Parnell Anderson firm name
Jackson county well located

LANDOWNER: William E McQueen

description of formations encountered	from	to
TOR Soil	0	3
Sandy Clay	3	8
Sand	8	24
Blue Clay	24	170
Five Sand	170	180
Five Sharp Sand	180	188

(mailing address)

WELL LOCATION:

sec. 12 T 7 S R 9 W
7 miles N.W. of Ocean Springs
(distance) (direction) (nearest town)

WELL PURPOSE: Home
(home, irrigation, municipal, industrial)

WELL COMPLETION DATA:

- (1) diameter (inches) 2
- (2) total depth (feet) 188
- (3) static water level (feet) 20 below above top of ground.
- (4) casing Plastic, 183 (material) (depth)
- (size) If telescope see back.
- (5) screen 5, 183 (length) (depth to top)
- 2, Plastic (size) (material)
- (6) pump 1, 10 (HP) (yield gpm)
- Elect (type power)
- (7) electric log (yes or no)

(organization running log)

(8) how well bottom plugged Backwash Valve

DRILLERS REMARKS:


CODED

DEC 8 1972

MISSISSIPPI
WATER BOARD

If well telescopes please sketch and show depths.

GROUND LEVEL

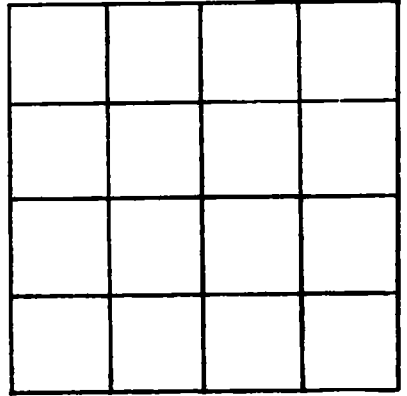

SECTION _____

Please indicate well location X.

ADDITIONAL INFORMATION

If more than one screen, show locations of each on sketch.