

JACKSON
N 428
5-18-73

MISSISSIPPI
BOARD OF WATER COMMISSIONERS

416 North State Street
Jackson, Mississippi 39201

CODED

WATER WELL DRILLERS LOG

R. J. MOORE

JACKSON

5-18-73

date well completed

firm name

county well located

LANDOWNER: L.P. BISHOP

PINE RD

~~Bill~~ Bilordi, MISS
(mailing address)

WELL LOCATION:

sec. 2 T. 7 N. R. 9 E. 35
5 miles N of ORCHARD SPRINGS
(distance) (direction) (nearest town)

WELL PURPOSE:

(home, irrigation, municipal, industrial)

WELL COMPLETION DATA:

- (1) diameter (inches) 2"
(2) total depth (feet) 410'
(3) static water level (feet) 33' below
top of ground.
(4) casing galv. 1100'
(material) (depth)

(size) If telescope see back.

- (5) screen 10' 1100'
(length) (depth to top)
2" SS
(size) (material)

- (6) pump 1 10
(HP) (yield gpm)

0
(type power)

- (7) electric log (yes or no)

(organization running log)

- (8) how well bottom plugged
Ben. 1/4" dia.

description of formations
encountered

from

to

TOP SOIL

0 10

WHITE SAND

10 20

White + Blue CLAY

20 40

Blue CLAY

110 100

GILTY Blue SAND

100 120

Blue CLAY

120 380

FINE GRAY SAND

380 390

COARSE GRAY SAND

390 410

CODED


JUN 12 1973

DRILLERS REMARKS:

MISS. BD. OF
WATER COMM

If well telescopes please sketch and show depths.

GROUND LEVEL

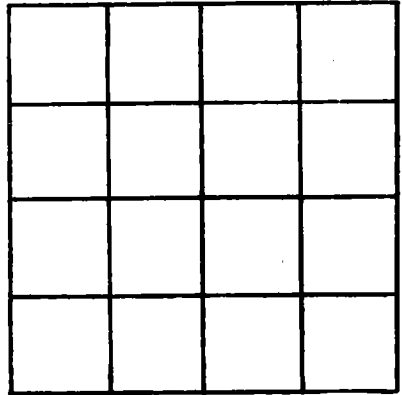

SECTION _____

Please indicate well location X.

ADDITIONAL INFORMATION

If more than one screen, show locations of each on sketch.