

JACKSON
N 430
4-15-73

MISSISSIPPI
BOARD OF WATER COMMISSIONERS
416 North State Street
Jackson, Mississippi 39201

CODED

WATER WELL DRILLERS LOG

COAST WATER WELL SERVICE

Jackson

4/15 1973
date well completed

firm name

county well located

LANDOWNER	description of formations encountered	from	to
<i>Minnie Taylor</i>	<i>top soil</i>	<i>0</i>	<i>5</i>
<i>Pt. 4 Box 424</i>			
<i>Ocean Springs Miss.</i> (mailing address)	<i>med. sand</i>	<i>5</i>	<i>20</i>
WELL LOCATION:	<i>Blue clay</i>	<i>20</i>	<i>35</i>
sec <i>23T</i> <i>7</i> <i>S</i> R <i>8</i> <i>W</i>	<i>med. sand</i>	<i>35</i>	<i>50</i>
<i>2</i> miles <i>E.N.E.</i> of <i>Ocean Springs</i>	<i>fine sand</i>	<i>50</i>	<i>126</i>
(distance) (direction) (nearest town)	<i>blue clay</i>	<i>126</i>	<i>440</i>
WELL PURPOSE: <i>Home</i>	<i>fine to med. sand</i>	<i>440</i>	<i>493</i>
(home, irrigation, municipal, industrial)			
WELL COMPLETION DATA:			
(1) diameter (inches) <i>2"</i>			
(2) total depth (feet) <i>493'</i>			
(3) static water level (feet) <i>40</i> below above top of ground.			
(4) casing <i>galv.</i> (material), <i>483'</i> (depth)			
<i>2"</i> (size) if telescope see back.			
(5) screen <i>10'</i> (length), <i>483'</i> (depth to top)			
<i>2"</i> (size), <i>stainless steel</i> (material)			
(6) pump (HP) (yield gpm)			
(type power)			
(7) electric log <i>NO</i> (yes or no)			
(organization running log)			
(8) how well bottom plugged <i>B.W</i> (value)			
DRILLERS REMARKS:			


CODED

JUN 25 1973

MISSISSIPPI
STATE ENGINEERING

If well telescopes please sketch and show depths.

GROUND LEVEL

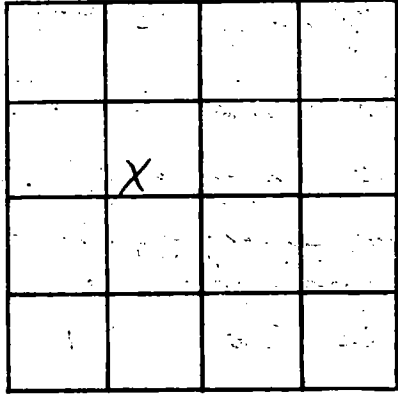

SECTION 23

Please indicate well location X.

ADDITIONAL INFORMATION

If more than one screen, show locations of each on sketch.