

JACKSON
N 433
2-5-73

MISSISSIPPI
BOARD OF WATER COMMISSIONERS
416 North State Street
Jackson, Mississippi 39201
WATER WELL DRILLERS LOG

CODED

2/5 1973 Coast Water Well Serv. Jackson
date well completed firm name county well located

LANDOWNER: J. B. Wright
rt. 3 Box 106
Ocean Springs, Ms.
(mailing address)

WELL LOCATION:
sec. 28 T. 7 S. R. 8 W.
1 miles east of Ocean Springs
(distance) (direction) (nearest town)

WELL PURPOSE: Home
(home, irrigation, municipal, industrial)

WELL COMPLETION DATA:

- (1) diameter (inches) 2"
- (2) total depth (feet) 550
- (3) static water level (feet) 50 below top of ground.
- (4) casing galv. 540'
(material) (depth)
2" if telescope see back.
(size)
- (5) screen 10' 540'
(length) (depth to top)
2" stainless steel
(size) (material)
- (6) pump 1 10
(HP) (yield gpm)
elec.
(type power)
- (7) electric log NO
(yes or no)

(organization running log)

description of formations encountered	from	to
<u>top soil</u>	<u>0</u>	<u>5</u>
<u>fine sand</u>	<u>5</u>	<u>25</u>
<u>Blue clay</u>	<u>25</u>	<u>60</u>
<u>fine to med sand</u>	<u>60</u>	<u>155</u>
<u>blue clay</u>	<u>155</u>	<u>189</u>
<u>fine sand</u>	<u>189</u>	<u>215</u>
<u>blue clay</u>	<u>215</u>	<u>520</u>
<u>coarse sand</u>	<u>520</u>	<u>550</u>


CODED

(8) how well bottom plugged Back
Washed


DRILLERS REMARKS:

JUN 25 1973

If well telescopes please sketch and show depths.

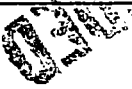

GROUND LEVEL

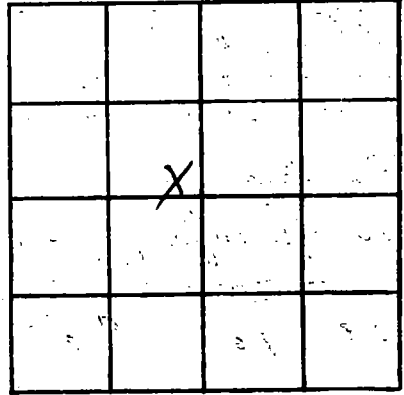

SECTION 28

Please indicate well location X.

ADDITIONAL INFORMATION

If more than one screen, show locations of each on sketch.