

JACKSON
 N 438
 6-21-73

MISSISSIPPI
 BOARD OF WATER COMMISSIONERS
 416 North State Street
 Jackson, Mississippi 39201

CODED

WATER WELL DRILLERS LOG

6-28 1973 Switzer Well Company Jackson
 date well completed firm name county well located

LANDOWNER: Leroy Smith
Rt. 5 Box 1876
Ocean Springs Miss.
 (mailing address)

description of formations encountered	from	to
Clay	0	138
fine sand	138	150
sand	150	172
lava sand	172	182
clay	182	299
sand	299	371

WELL LOCATION:
 sec. 8 T. 7 S. R. 9 W.
2 1/2 miles NE of OS
 (distance) (direction) (nearest town)

WELL PURPOSE: home
 (home, irrigation, municipal, industrial)

WELL COMPLETION DATA:

(1) diameter (inches) 2"

(2) total depth (feet) 371 feet

(3) static water level (feet) 43 below
 top of ground.

(4) casing galv. 371'
 (material) (depth)
4" if telescope see back.
 (size)

(5) screen 20' 351'
 (length) (depth to top)
008 stainless steel
 (size) (material)

(6) pump 1 (hplm.) 20
 (HP) (yield gpm)
electric
 (type power)

(7) electric log no
 (yes or no)

(organization running log)


(8) how well bottom plugged back
pressure valve

DRILLERS REMARKS:

AUG 1 1973

If well telescopes please sketch and show depths.

GROUND LEVEL

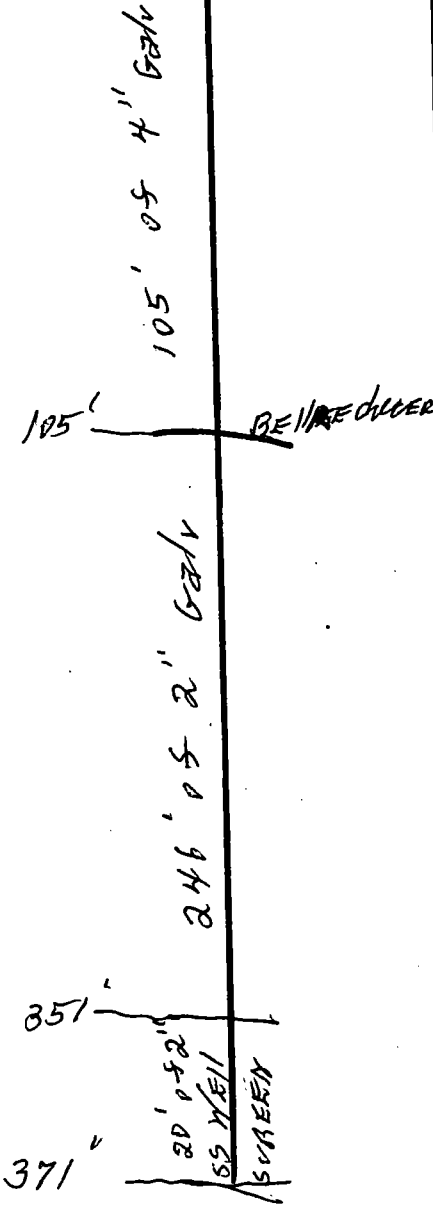

			X

SECTION 8

Please indicate well location X.

ADDITIONAL INFORMATION

If more than one screen, show locations of each on sketch.