

JACKSON
N 439
7-11-73

MISSISSIPPI
BOARD OF WATER COMMISSIONERS
416 North State Street
Jackson, Mississippi 39201

WATER WELL DRILLERS LOG **CODED**

7-11-1973 date well completed
Switzer Well Co. firm name
Jackson county well located

LANDOWNER: Howard Duggan

Kenneth Drive

Ocean Springs, Miss.
(mailing address)

WELL LOCATION:

sec. 14 T. 7 S. R. 5 W.
1/4 miles N of PS
(distance) (direction) (nearest town)

WELL PURPOSE: home
(home, irrigation, municipal, industrial)

WELL COMPLETION DATA:

- (1) diameter (inches) 2"
- (2) total depth (feet) 371 feet
- (3) static water level (feet) 39 ^{below} _{above} top of ground.
- (4) casing galv. 371'
(material) (depth)
- If telescope see back.
(size)
- (5) screen 10' 361'
(length) (depth to top)
- 008 stainless steel
(size) (material)
- (6) pump 1/2 8
(HP) (yield gpm)
- electric
(type power)
- (7) electric log no
(yes or no)
- (organization running log)

description of formations encountered

from to

<u>Clay - mud str.</u>	<u>0</u>	<u>23</u>
<u>Clay</u>	<u>23</u>	<u>57</u>
<u>sand</u>	<u>57</u>	<u>62</u>
<u>Clay</u>	<u>62</u>	<u>87</u>
<u>soft clay</u>	<u>87</u>	<u>108</u>
<u>Clay</u>	<u>108</u>	<u>215</u>
<u>sand</u>	<u>215</u>	<u>228</u>
<u>clay</u>	<u>228</u>	<u>253</u>
<u>sand</u>	<u>253</u>	<u>261</u>
<u>Clay</u>	<u>261</u>	<u>311</u>
<u>fine sand</u>	<u>311</u>	<u>319</u>
<u>Clay</u>	<u>319</u>	<u>352</u>
<u>fine sand</u>	<u>352</u>	<u>371</u>


DRILLERS REMARKS:

AUG 1 1973

MISS. BD. OF
WATER COMM.

If well telescopes please sketch and show depths.

GROUND LEVEL

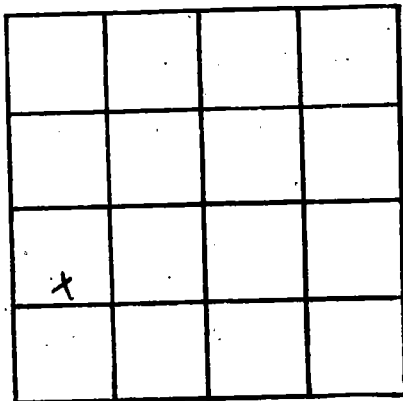

SECTION 18

Please indicate well location X.

ADDITIONAL INFORMATION

If more than one screen, show locations of each on sketch.