

JACKSON  
N 442  
7-18-73

MISSISSIPPI  
BOARD OF WATER COMMISSIONERS  
416 North State Street  
Jackson, Mississippi 39201

**CODED**

WATER WELL DRILLERS LOG  
COASTAL DRILLING & SERVICE CO.

date well completed 7/18 1973  
ROUTE 1 BOX # 518 name

Jackson  
county well located

LANDOWNER: Bud Jones BILOXI, MISS. 39532

Rest Rt of Belfo  
Biloxi, Miss  
(mailing address)

description of formations encountered	from	to
<u>top soil</u>	<u>1</u>	<u>3</u>
<u>Super Sand</u>	<u>3</u>	<u>12</u>
<u>White Sand</u>	<u>12</u>	<u>50</u>
<u>Soft Blue Clay</u>	<u>50</u>	<u>200</u>
<u>fine water sand</u>	<u>200</u>	<u>230</u>
<u>Rose water sand</u>	<u>230</u>	<u>250</u>

WELL LOCATION:

sec. 10 T. 7 S. R. 9 W.  
10 1/2 miles (distance) W (direction) of W (nearest town)

WELL PURPOSE: Rest  
(home, irrigation, municipal, industrial)

WELL COMPLETION DATA:

- (1) diameter (inches) 2"  
(2) total depth (feet) 250'  
(3) static water level (feet) 31' below above top of ground.  
(4) casing slat. 240'  
(material) (depth)



- \_\_\_\_\_ if telescope see back.  
(size)  
(5) screen 10' 240'  
(length) (depth to top)  
2" S.S.  
(size) (material)

- (6) pump 0m 18'  
(HP) (yield gpm)  
Elc.  
(type power)

- (7) electric log no  
(yes or no)

(organization running log)

- (8) how well bottom plugged 2" backwash valve

DRILLERS REMARKS:


none

SEP 7 1973

MISS. HD. 0-  
WATER COM.

If well telescopes please sketch and show depths.

GROUND LEVEL

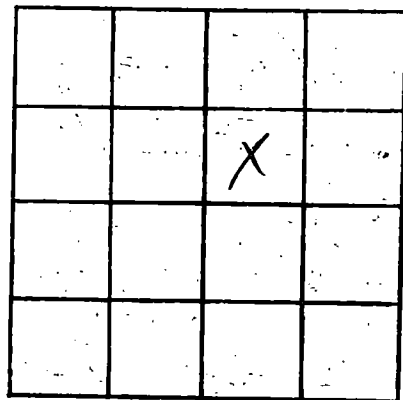

SECTION \_\_\_\_\_

Please indicate well location X.

ADDITIONAL INFORMATION

If more than one screen, show locations of each on sketch.