

CODED

MISSISSIPPI BOARD OF WATER COMMISSIONERS
416 North State Street
Jackson, Mississippi 39201

WATER WELL DRILLERS LOG

N 447
JACKSON
10-9-73

10-9-1973 date well completed
Sutton Well Co. firm name
JACKSON county well located

LANDOWNER: Harvey Jeff

description of formations encountered	from	to
Clay-mixed	0	21
mixed	21	41
sand-clay	41	61
clay	61	81
sand	81	111
clay	111	220
mixed	220	230
clay	230	284
sand	284	288
clay	288	319
shale-clay	319	338
sand	338	398
clay	398	417
clay-shale	417	437
mixed	437	457
clay-shale	457	477
clay	477	485
sand	485	491
clay	491	497
shale + clay	497	537
fine sand	537	591

(mailing address)

WELL LOCATION:

sec. 7 T. 7 S. R. 8 W.
4 miles N of Ocean Springs
(distance) (direction) (nearest town)

WELL PURPOSE: Home
(home, irrigation, municipal, industrial)


WELL COMPLETION DATA:

- (1) diameter (inches) 2"
- (2) total depth (feet) 591'
- (3) static water level (feet) 44 ^{below}/_{above} top of ground.
- (4) casing galv 591'
(material) (depth)
- (size) if telescope see back.
- (5) screen 10' 581'
(length) (depth to top)
- 008 stainless steel
(size) (material)
- (6) pump 1 10.0
(HP) (yield gpm)
- elec.
(type power)
- (7) electric log no
(yes or no)
- (organization running log)
- (8) how well bottom plugged back
pressure valve

DRILLERS REMARKS: WIN 5 10/73

If well telescopes please sketch and show depths.

GROUND LEVEL

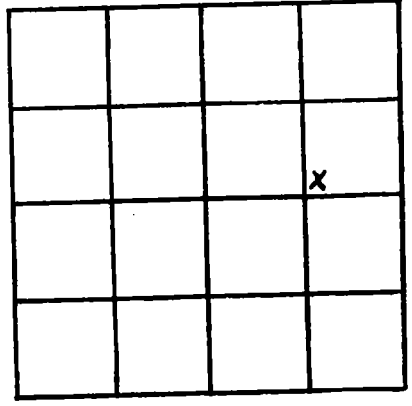

SECTION 7

Please indicate well location X.

ADDITIONAL INFORMATION

A series of horizontal lines for writing additional information.

If more than one screen, show locations of each on sketch.