

**JACKSON**  
**N 449**  
**10-1-73**

MISSISSIPPI  
 BOARD OF WATER COMMISSIONERS  
 416 North State Street  
 Jackson, Mississippi 39201.

**CODED**


**WATER WELL DRILLERS LOG**

<sup>10/1</sup> 19<sup>73</sup> date well completed      firm name Jackson      county well located

| LANDOWNER: <u>David Noble</u>   | description of formations encountered | from       | to         |
|---|---------------------------------------|------------|------------|
| <u>Rt. 6 Box 382</u>  |                                       |            |            |
| <u>Ocean Springs, Mo.</u><br>(mailing address)  | <u>red clay</u>                       | <u>5</u>   | <u>10</u>  |
| WELL LOCATION:<br>sec. <u>23</u> T. <u>7</u> S. R. <u>8</u> W.                              | <u>coarse sand</u>                    | <u>10</u>  | <u>15</u>  |
| <u>3</u> miles <u>East</u> of <u>Ocean Springs</u><br>(distance) (direction) (nearest town) | <u>fine sand</u>                      | <u>15</u>  | <u>136</u> |
| WELL PURPOSE: <u>Home</u><br>(home, irrigation, municipal, industrial)                      | <u>blue clay</u>                      | <u>136</u> | <u>326</u> |
| WELL COMPLETION DATA:   | <u>fine sand</u>                      | <u>326</u> | <u>344</u> |
| (1) diameter (inches) <u>2"</u>   | <u>Blue clay</u>                      | <u>344</u> | <u>378</u> |
| (2) total depth (feet) <u>494'</u>  | <u>fine sand</u>                      | <u>378</u> | <u>385</u> |
| (3) static water level (feet) <u>40</u> below top of ground.                                | <u>Blue clay</u>                      | <u>385</u> | <u>410</u> |
| (4) casing <u>galv.</u> <u>484'</u><br>(material) (depth)                                   | <u>fine sand</u>                      | <u>410</u> | <u>752</u> |
| <u>2"</u> if telescope see back.<br>(size)  | <u>Med. sand</u>                      | <u>752</u> | <u>794</u> |
| (5) screen <u>10'</u> <u>484'</u><br>(length) (depth to top)                                |                                       |            |            |
| <u>2"</u> <u>Stainless Steel</u><br>(size) (material)                                       |                                       |            |            |
| (6) pump <u>1</u> <u>10</u><br>(HP) (yield gpm)   |                                       |            |            |
| <u>elec.</u><br>(type power)  |                                       |            |            |
| (7) electric log <u>NO</u><br>(yes or no)   |                                       |            |            |
| (organization running log)  |                                       |            |            |
| (8) how well bottom plugged<br><u>Backwash Valve</u>  |                                       |            |            |
| DRILLERS REMARKS:   |                                       |            |            |

If well telescopes please sketch and show depths.

GROUND LEVEL

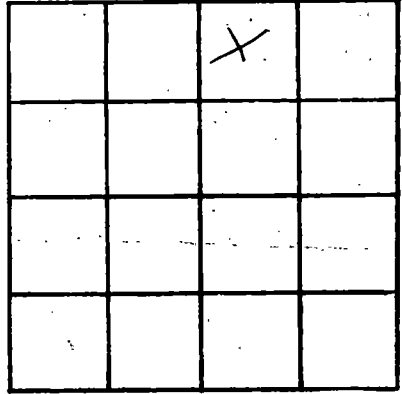

SECTION 23

Please indicate well location X.

ADDITIONAL INFORMATION

If more than one screen, show locations of each on sketch.