

JACKSON  
N 452  
2-20-74

MISSISSIPPI  
BOARD OF WATER COMMISSIONERS  
416 North State Street  
Jackson, Mississippi 39201

WATER WELL DRILLERS LOG

2-20-74 19 R. J. Moore JACKSON  
date well completed firm name county well located

LANDOWNER: J. R. MASON  
1617 Race Trade RD  
Billow, MISS  
(mailing address)  
WELL LOCATION:  
sec. 16 T. 2 N. R. 9 E  
2 miles N of Billow  
(distance) (direction) (nearest town)

description of formations encountered	from	to
TOP SOIL	0	10
TOP SAND	10	20
Clay	20	20
white sand	20	20
Blue Clay	20	200
SILT sand	200	230
Red Clay	230	320
GRAY SAND	320	350

WELL PURPOSE:  
(home, irrigation, municipal, industrial)

WELL COMPLETION DATA:  
(1) diameter (inches) 2"  
(2) total depth (feet) 350'  
(3) static water level (feet) 43' below top of ground  
(4) casing 9 1/2" 340'  
(material) (depth)  
(size) If telescope see back.  
(5) screen 10' 350'  
(length) (depth to top)  
2" SS  
(size) (material)  
(6) pump 1 8  
(HP) (yield gpm)  
E  
(type power)  
(7) electric log                       
(yes or no)  
    
(organization running log)  
(8) how well bottom plugged                       
                    


CODED

DRILLERS REMARKS:   

10MM

If well telescopes please sketch and show depths.

GROUND LEVEL

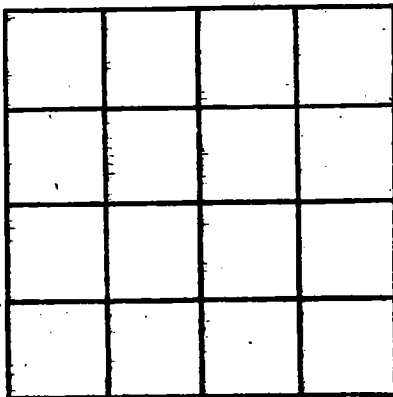

SECTION \_\_\_\_\_

Please indicate well location X.

ADDITIONAL INFORMATION

If more than one screen, show locations of each on sketch.