

JACKSON  
 N 453  
 3-23-74

MISSISSIPPI  
 BOARD OF WATER COMMISSIONERS  
 416 North State Street  
 Jackson, Mississippi 39201

CODED

WATER WELL DRILLERS LOG

23 March 1974 Bryant Well Co Jackson  
 date well completed firm name county well located


LANDOWNER: <u>ROY COOK</u>	description of formations encountered	from	to
<u>RT 3 Box 321</u>	<u>Clay w/sand streaks</u>	<u>0</u>	<u>44</u>
<u>Biloxi, Ms.</u> (mailing address)	<u>Clay</u>	<u>44</u>	<u>127</u>
WELL LOCATION: sec. <u>12</u> T- <u>7</u> S R- <u>9</u> W	<u>Sand</u>	<u>127</u>	<u>130</u>
<u>3</u> miles <u>NE</u> of <u>Biloxi</u> (distance) (direction) (nearest town)	<u>Clay</u>	<u>130</u>	<u>203</u>
WELL PURPOSE: <u>HOME</u> (home, irrigation, municipal, industrial)	<u>Sand (FINE)</u>	<u>203</u>	<u>221</u>
WELL COMPLETION DATA: (1) diameter (inches) <u>2"</u>	<u>Clay</u>	<u>221</u>	<u>343</u>
(2) total depth (feet) <u>471'</u>	<u>Sand</u>	<u>343</u>	<u>352</u>
(3) static water level (feet) <u>44</u> below top of ground.	<u>Clay</u>	<u>352</u>	<u>417</u>
(4) casing <u>Galv.</u> , <u>461'</u> (material) (depth)	<u>Sand (COARSE)</u>	<u>417</u>	<u>471</u>
(size) If telescope see back.			
(5) screen <u>10'</u> , <u>461'</u> (length) (depth to top)			
<u>2"</u> , <u>3/8"</u> (size) (material)			
(6) pump _____ (HP) (yield gpm)			
(type power)			
(7) electric log <u>NO</u> (yes or no)			
(organization running log)			
(8) how well bottom plugged <u>METAL</u> <u>BACK PRESSURE VALVE</u>			
DRILLERS REMARKS:			

CODED

DEPARTMENT OF  
 WATER RESOURCES  
 MISSISSIPPI

If well telescopes please sketch and show depths.

GROUND LEVEL

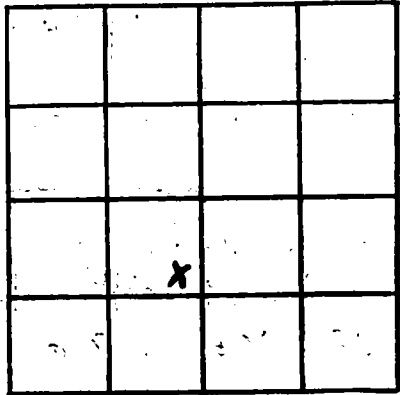

SECTION 12

Please indicate well location X.

ADDITIONAL INFORMATION

If more than one screen, show locations of each on sketch.