

**JACKSON**  
**N 455**  
**6-22-74**

MISSISSIPPI  
 BOARD OF WATER COMMISSIONERS  
 416 North State Street  
 Jackson, Mississippi 39201


**CODED**

**WATER WELL DRILLERS LOG**

22 JUNE 74 1974 BRYANT WELL CO JACKSON  
 date well completed firm name county well located

LANDOWNER: <u>H.C. BRYANT</u>	description of formations encountered	from	to
<u>RT 3 Box 314-A</u> <u>Biloxi, Ms.</u> (mailing address)			
<b>WELL LOCATION:</b> sec <u>12</u> T <u>7</u> S R <u>9</u> W <u>3</u> miles <u>NW</u> of <u>ROSEN SPRING</u> (distance) (direction) (nearest town)	<u>CLAY</u>	<u>0</u>	<u>9</u>
<b>WELL PURPOSE:</b> <u>HOME</u> (home, irrigation, municipal, industrial)	<u>SAND</u>	<u>9</u>	<u>19</u>
<b>WELL COMPLETION DATA:</b>	<u>CLAY</u>	<u>19</u>	<u>44</u>
(1) diameter (inches) <u>2</u>	<u>SAND</u>	<u>44</u>	<u>63</u>
(2) total depth (feet) <u>249</u>	<u>CLAY</u>	<u>63</u>	<u>131</u>
(3) static water level (feet) <u>59</u> below top of ground.	<u>SAND</u>	<u>131</u>	<u>166</u>
(4) casing <u>PVC</u> , <u>239</u> , (material) (depth)	<u>CLAY</u>	<u>166</u>	<u>204</u>
<u>    </u> If telescope see back. (size)	<u>SAND</u>	<u>204</u>	<u>249</u>
(5) screen <u>10'</u> , <u>239</u> (length) (depth to top)			
<u>2"</u> , <u>PVC</u> (size) (material)			
(6) pump <u>1</u> (HP) <u>10</u> (yield gpm)			
<u>ELECT</u> (type power)			
(7) electric log <u>No</u> (yes or no)			
<u>    </u> (organization running log)			
(8) how well bottom plugged <u>PVC</u> <u>ROCK PRESSURE VALVE</u>			
<b>DRILLERS REMARKS:</b>			

**CODED**

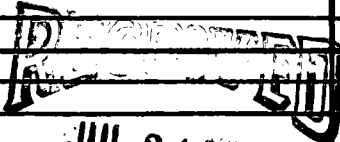

JUL 24 1974

MISS. BD. OF WATER COMM

If well telescopes please sketch and show depths.

GROUND LEVEL

X			

SECTION 12

Please indicate well location X.

**ADDITIONAL INFORMATION**

If more than one screen, show locations of each on sketch.