

**JACKSON**  
**N 456**  
**C-29-79**

MISSISSIPPI  
 BOARD OF WATER COMMISSIONERS  
 416 North State Street  
 Jackson, Mississippi 39201  
**WATER WELL DRILLERS LOG**

**CODED**

24 JUNE 74 BRYANT WELL CO JACKSON  
 date well completed firm name county well located

LANDOWNER: <u>Bay Water Works</u>	description of formations encountered	from	to
<u>PO Box 371</u>			
<u>Biloxi, Ms.</u> (mailing address)	<u>CLAY</u>	<u>0</u>	<u>12</u>
<b>WELL LOCATION:</b>	<u>SAND</u>	<u>12</u>	<u>23</u>
sec. <u>10</u> T. <u>7</u> S. R. <u>9</u> W.	<u>CLAY</u>	<u>23</u>	<u>33</u>
<u>0</u> miles <u>NE</u> of <u>Biloxi</u> (distance) (direction) (nearest town)	<u>SAND</u>	<u>33</u>	<u>49</u>
<b>WELL PURPOSE:</b> <u>HOME</u> (home, irrigation, municipal, industrial)	<u>CLAY</u>	<u>49</u>	<u>111</u>
<b>WELL COMPLETION DATA:</b>	<u>SAND</u>	<u>111</u>	<u>122</u>
(1) diameter (inches) <u>2</u>	<u>CLAY</u>	<u>122</u>	<u>139</u>
(2) total depth (feet) <u>225</u>	<u>SAND</u>	<u>139</u>	<u>149</u>
(3) static water level (feet) <u>38</u> below top of ground.	<u>CLAY</u>	<u>149</u>	<u>190</u>
(4) casing <u>PVC</u> , <u>215</u> , (material) (depth)	<u>SAND</u>	<u>190</u>	<u>225</u>
<u>      </u> if telescope see back. (size)			
(5) screen <u>10'</u> , <u>215</u> (length) (depth to top)			
<u>2</u> , <u>5/8</u> (size) (material)			
(6) pump <u>      </u> <u>      </u> (HP) (yield gpm)			
<u>      </u> (type power)			
(7) electric log <u>NO</u> (yes or no)			
<u>      </u> (organization running log)			
(8) how well bottom plugged <u>METAL BACK PRESSURE VALVE</u>			
<b>DRILLERS REMARKS:</b>			

**CODED**


**RECEIVED**

JUL 24 1974

MISS. BD. OF WATER COMM

If well telescopes please sketch and show depths.

GROUND LEVEL

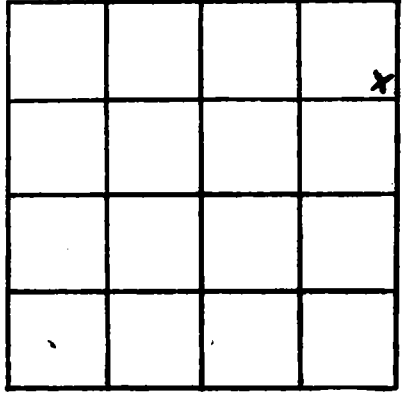

SECTION 10

Please indicate well location X.

ADDITIONAL INFORMATION

If more than one screen, show locations of each on sketch.