

Jackson
 N 457
 2-13-74

MISSISSIPPI
 BOARD OF WATER COMMISSIONERS
 416 North State Street
 Jackson, Mississippi 39201

CODED

WATER WELL DRILLERS LOG
 COASTAL DRILLING & SERVICE CO.

2/13 1974
 date well completed

ROUTE 1 BOX 618

Jackson
 county well located

LANDOWNER Benny Hill

39552 description of formations encountered

P.O. Box 618
 Ocean Springs, Miss
 (mailing address)

description of formations encountered	from	to
top soil	1	3
yellow sand	3	17
white sand	17	38
red sand	38	70
yellow sand	70	110
soft blue clay	110	235
hard blue clay	235	420
fine white sand	420	450
coarse white sand	450	480

WELL LOCATION:
 sec 19 T 7 N R 8 E
 S W
 Gulf Hills
 (distance) (direction) (nearest town)

WELL PURPOSE: home
 (home, irrigation, municipal, industrial)

WELL COMPLETION DATA:

- (1) diameter (inches) 2"
- (2) total depth (feet) 480'
- (3) static water level (feet) 10 below top of ground
- (4) casing PVC, 470'
 (material) (depth)
- (5) screen 10', 470'
 (length) (depth to top)
- (6) pump 1/2, 17
 (HP) (yield gpm)
- (7) electric log no
 (yes or no)

CODED

(organization running log)

(8) how well bottom plugged 2"
hard wash valve


DRILLERS REMARKS: none

RECEIVED
 AUG 15 1974

MISS. BD. OF WATER COMMISSIONERS

If well telescopes please sketch and show depths.

GROUND LEVEL

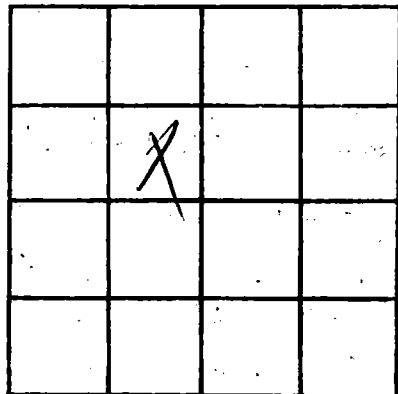

SECTION _____

Please indicate well location X.

ADDITIONAL INFORMATION

If more than one screen, show locations of each on sketch.