

Jackson  
 N 460  
 11/18/74

MISSISSIPPI  
 BOARD OF WATER COMMISSIONERS  
 416 North State Street  
 Jackson, Mississippi 39201

CODED

WATER WELL DRILLERS LOG

Garland Water Wells

Jackson

18 November 1974  
 date well completed

firm name

county well located

LANDOWNER: Bobby Schriber  
510 Ward Ave.  
Deer Springs Ms 39564  
 (mailing address)


description of formations encountered	from	to
Top Soil	1	3
Red Clay	3	12
Sand - white	12	61
Mud	61	66
Sand - S/P	66	157
Mud	157	212
Sand - S/P	212	233
Mud	233	

WELL LOCATION:  
 sec. 12 T 7 S R 8 W  
5 miles NORTH of Deer Springs  
 (distance) (direction) (nearest town)

WELL PURPOSE: HOME  
 (home, irrigation, municipal, industrial)

CODED

- WELL COMPLETION DATA:
- (1) diameter (inches) 2"
  - (2) total depth (feet) 230'
  - (3) static water level (feet) \_\_\_\_\_ below/above top of ground.
  - (4) casing Gal. Steel 220  
 (material) (depth)  
2" If telescope see back.  
 (size)
  - (5) screen 10', 230'-220'  
 (length) (depth to top)  
2", Stainless Steel  
 (size) (material)
  - (6) pump None \_\_\_\_\_  
 (HP) (yield gpm)  
 \_\_\_\_\_  
 (type power)
  - (7) electric log No  
 (yes or no)  
N/A  
 (organization running log)
  - (8) how well bottom plugged Float  
Ball

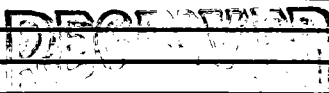


NOV 22 1974

DRILLERS REMARKS:

If well telescopes please sketch and show depths.

GROUND LEVEL

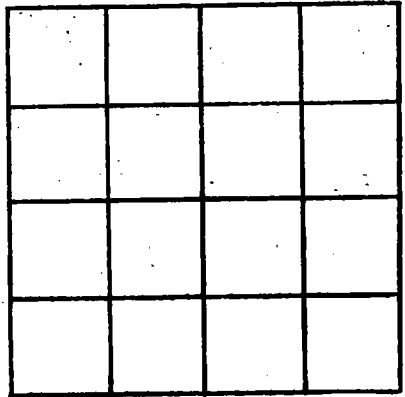

SECTION \_\_\_\_\_

Please indicate well location X.

ADDITIONAL INFORMATION

A series of horizontal lines for providing additional information.

If more than one screen, show locations of each on sketch.