

**JACKSON**  
**N466**  
**8-18-74**

MISSISSIPPI  
 BOARD OF WATER COMMISSIONERS **CODED**  
 416 North State Street  
 Jackson, Mississippi 39201

**WATER WELL DRILLERS LOG**

8/18 19 74 COAST WATER WELL SERVICE Jackson  
 date well completed firm name county well located

LANDOWNER: <u>John W Adams</u> <u>601 Pine Hill Rd.</u> <u>Ocean Springs, Ms.</u> (mailing address)	description of formations encountered	from	to
	<u>top soil</u>	<u>0</u>	<u>15</u>
	<u>Blue Clay</u>	<u>15</u>	<u>52</u>
	<u>Coarse Sand</u>	<u>52</u>	<u>60</u>
<b>WELL LOCATION:</b>			
sec. <u>29</u> T. <u>7</u> N. R. <u>8</u> E. <u>in</u> <u>Ocean Springs</u> (distance) miles (direction) of (nearest town)			
<b>WELL PURPOSE:</b> <u>yard</u> (home, irrigation, municipal, industrial)			
<b>WELL COMPLETION DATA:</b>			
(1) diameter (inches) <u>2"</u>			
(2) total depth (feet) <u>60'</u>			
(3) static water level (feet) <u>19</u> below above top of ground.			
(4) casing <u>PVC</u> , <u>55'</u> (material) (depth) <u>2"</u> if telescope see back. (size)			
(5) screen <u>10'</u> , <u>55'</u> (length) (depth to top) <u>2"</u> <u>PVC</u> (size) (material)			
(6) pump <u>1/2</u> <u>7</u> (HP) (yield gpm) <u>elec.</u> (type power)			
(7) electric log <u>NO</u> (yes or no)			
(organization running log)			
(8) how well bottom plugged <u>BW 2</u>			

**REC'D**


**MAY 18 1975**

**MISS. BD. OF WATER**

DRILLERS REMARKS:

If well telescopes please sketch and show depths.

GROUND LEVEL

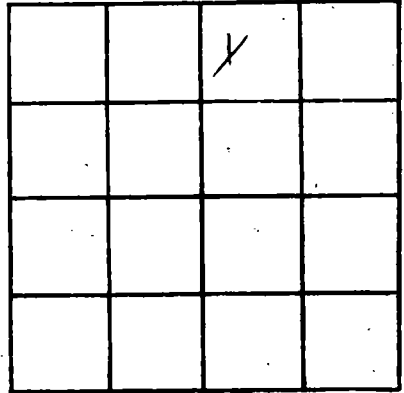

SECTION 29

Please indicate well location X.

ADDITIONAL INFORMATION

If more than one screen, show locations of each on sketch.