

MISSISSIPPI
 BOARD OF WATER COMMISSIONERS
 416 North State Street
 Jackson, Mississippi 39201

CODED

WATER WELL DRILLERS LOG

COASTAL DRILLING & SERVICE CO. *Jackson*

ROUTE 1 BOX 618

county well located

3/7/75
 date well completed

LANDOWNER: *See Appendix*

location of formations encountered

from

to

612 Chaugult
N. B. B. B. Miss
 (mailing address)

<i>Top Soil</i>	<i>1</i>	<i>3</i>
<i>white Sand & gravel</i>	<i>3</i>	<i>33</i>
<i>Soft Clay</i>	<i>33</i>	<i>105</i>
<i>hard white clay</i>	<i>105</i>	<i>160</i>
<i>Coarse white sand</i>	<i>160</i>	<i>172</i>

WELL LOCATION: *135*

sec *10* T *7* N R *9* E
 S W
2 1/2 miles *W* of *Chief Hill*
 (distance) (direction) (nearest town)

WELL PURPOSE: *Home*
 (home, irrigation, municipal, industrial)

WELL COMPLETION DATA:

- (1) diameter (inches) *2"*
- (2) total depth (feet) *172'*
- (3) static water level (feet) *5* below above top of ground.
- (4) casing *PVC, 162'*
 (material) (depth)
 (size) if telescope see back.
- (5) screen *10'*, *162'*
 (length) (depth to top)
2", *PVC*
 (size) (material)
- (6) pump _____ (HP) _____ (yield gpm)
Ele
 (type power)
- (7) electric log *no*
 (yes or no)
 (organization running log)

(8) how well bottom plugged

2" back wash valve


DRILLERS REMARKS:

RECEIVED
 DIVISION
 JUL 17 1975

MISS. BD. OF WATER COMM

If well telescopes please sketch and show depths.

GROUND LEVEL

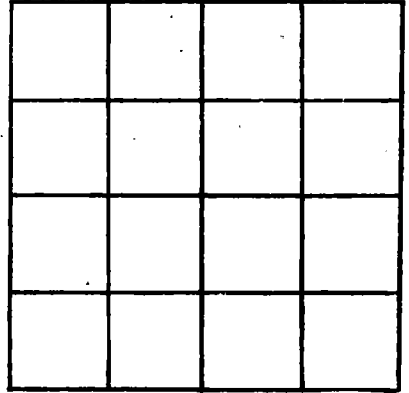

SECTION _____

Please indicate well location X.

ADDITIONAL INFORMATION

If more than one screen, show locations of each on sketch.