

Jackson
 N 469
 6-30-75

MISSISSIPPI
 BOARD OF WATER COMMISSIONERS
 416 North State Street
 Jackson, Mississippi 39201

CODED

WATER WELL DRILLERS LOG

COASTAL DRILLING & SERVICE of Jackson

6/30 1975
 date well completed

ROUTE first no BOX 618

county well located

LANDOWNER: L.M. Hickman

description of formations encountered

from to

Ocean Springs, Miss
 (mailing address)

| | | |
|------------------|-----|-----|
| Top Soil | 1 | 3 |
| Red Soil + Clay | 3 | 40 |
| White Sand dune | 40 | 170 |
| Soft Blue Clay | 170 | 270 |
| Water Sand | 270 | 290 |
| Hard Blue Clay | 290 | 340 |
| Coarse Well Sand | 340 | 375 |

WELL LOCATION:

sec. 18 T 2 N R 8 E 13S
 S W

1/4 mile N Gulf Hill
 (distance) (direction) (nearest town)


WELL PURPOSE: Home
 (home, irrigation, municipal, industrial)

WELL COMPLETION DATA:

- (1) diameter (inches) 2"
- (2) total depth (feet) 365
- (3) static water level (feet) 40 below top of ground.
- (4) casing P.C. 3.55' (material) (depth)
- (5) screen 10' 3.55' (length) (depth to top)
 3" P.C. (size) (material)
- (6) pump One 12 (HP) (yield gpm)
 Elec (type power)
- (7) electric log no (yes or no)
- (organization running log)

(8) how well bottom plugged
 2" Hard Well Water

DRILLERS REMARKS:

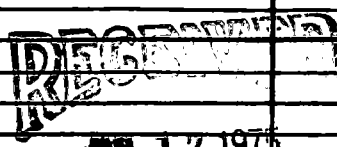

JUN 17 1975

