

Call about
Name

MISSISSIPPI
BOARD OF WATER COMMISSIONERS
416 North State Street
Jackson, Mississippi 39201

CODED

WATER WELL DRILLERS LOG

COASTAL DRILLING & SERVICE CO.

Jackson
county well located

Jackson
N 470
4-29-74

4/29 1974 date well completed

ROUTE 1 BOX 678

LANDOWNER Bill Miley, MISS

description of formations encountered

from to

Rt 3 Box 289

Top Soil 1 5

Bilboi Morris
(mailing address)

Red Clay Sand 5 25

WELL LOCATION:

Coarse White Sand 25 48

sec 1 T 7 N R 9 E 135
S W
2 1/2 miles NW of Huff Hill
(distance) (direction) (nearest town)

Shale 48 210

WELL PURPOSE: drill
(home, irrigation, municipal, industrial)

Hard Blue Cl. 510 314

WELL COMPLETION DATA:

fine water sand 314 325

(1) diameter (inches) 2 1/2"

med water sand 325 390

(2) total depth (feet) 390'

(3) static water level (feet) 30 below above top of ground.

(4) casing PVC, 375'
(material) (depth)

2 1/4"
(size) if telescope see back.

(5) screen 15', 375'
(length) (depth to top)

2", PVC
(size) (material)

(6) pump one, 20
(HP) (yield gpm)

Ele
(type power)


(7) electric log no
(yes or no)

(organization running log)

(8) how well bottom plugged

2' hard water sand

DRILLERS REMARKS:

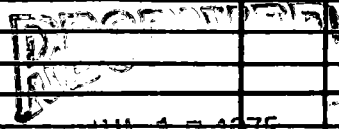

JUL 17 1975

MISS. BD. OF WATER COMM.

435 3738

If well telescopes please sketch and show depths.

GROUND LEVEL

SECTION _____

Please indicate well location X.

ADDITIONAL INFORMATION

If more than one screen, show locations of each on sketch.