

Jackson
N 472
2-17-75

MISSISSIPPI
BOARD OF WATER COMMISSIONERS
416 North State Street
Jackson, Mississippi 39201

CODED

WATER WELL DRILLERS LOG
COASTAL DRILLING & BOREHOLE SERVICES

Jackson
county well located

2/17/75
date well completed
ROUTE 1 BOX 618
BILBO, MISS. 39532

LANDOWNER: Fraser Murray
Home Supply Co.
Ocean Springs, Miss
(mailing address)

Description of formations encountered	from	to
Top Soil	1	3
Red Clay	3	15
White Sand	15	35
Soft Sand	35	115
Fine water sand	115	135
Hard Blue Shale	135	200
Coarse water sand	200	235

WELL LOCATION:
sec. 14 T 7 N R 9 E 135
S W
0.0 miles NE of New Gulf Hills
(distance) (direction) (nearest town)


WELL PURPOSE: Household
(home, irrigation, municipal, industrial)

- WELL COMPLETION DATA:
- (1) diameter (inches) 4"
 - (2) total depth (feet) 235
 - (3) static water level (feet) 15 below above top of ground.
 - (4) casing PVC, 220'
(material) (depth)
4"
(size) if telescope see back.
 - (5) screen 15', 220'
(length) (depth to top)
4" PVC
(size) (material)
 - (6) pump 2 Hp 40
(HP) (yield gpm)
Ele
(type power)
 - (7) electric log no
(yes or no)

(organization running log)

(8) how well bottom plugged
sp. hard brown water

DRILLERS REMARKS:

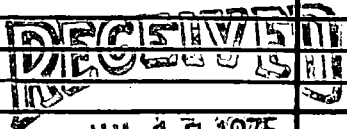

If well telescopes please sketch and show depths.

GROUND LEVEL

SECTION _____

Please indicate well location X.

ADDITIONAL INFORMATION

If more than one screen,
show locations of each on sketch.