

Jackson  
N 473  
5-18-75

MISSISSIPPI  
BOARD OF WATER COMMISSIONERS  
416 North State Street  
Jackson, Mississippi 39201

CODED

WATER WELL DRILLERS LOG

COASTAL DRILLING & SERVICE CO. *Jackson*

5/18/75  
date well completed

ROUTE 1 <sup>firm</sup> BOX #618

county well located

LANDOWNER

*Vincient* BILOXI, MISS 39532

Description of formations encountered

from to

*Calaboult Pt 1 Bafford*

*top soil*

*1 3*

*Ocean Spring, Min*  
(mailing address)

*Soft Sand*

*3 15*

WELL LOCATION:

sec. *1* T. *2* N. R. *9* E. *135*

*White Sand*

*15 45*

*3 1/2* miles *NW* of *Helf Hill*  
(distance) (direction) (nearest town)

*Soft Muds*

*45 190*

WELL PURPOSE:

*Home*  
(home, irrigation, municipal, industrial)

*fine water sand*

*190 220*

WELL COMPLETION DATA:

(1) diameter (inches) *2"*

*Shelly Sand*

*220 225*

(2) total depth (feet) *340'*

*hard clay*

*225 305*

(3) static water level (feet) *37* below above top of ground.

*fine water sand*

*305 320*

(4) casing *PVC*, *330'*  
(material) (depth)

*Coarse water sand*

*320 340*

(size) if telescope see back.

(5) screen *10'*, *330'*  
(length) (depth to top)

*2"*, *PVC*  
(size) (material)

(6) pump *one*, *12*  
(HP) (yield gpm)

*Ell*  
(type power)

(7) electric log *no*  
(yes or no)

(organization running log)

(8) how well bottom plugged  
*2" hard water valve*


DRILLERS REMARKS:

RECEIVED  
JUL 17 1975

MISS. BD. OF WATER

If well telescopes please sketch and show depths.

GROUND LEVEL

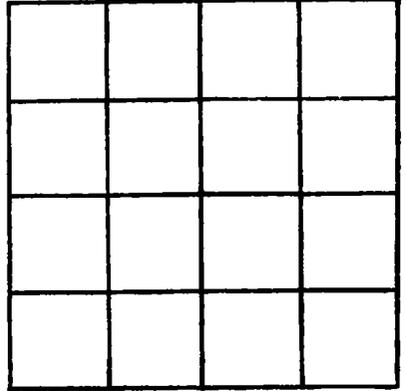

SECTION \_\_\_\_\_

Please indicate well location X.

ADDITIONAL INFORMATION

If more than one screen, show locations of each on sketch.