

Jackson
N 474
5-12-75
5/2/75
date well completed

MISSISSIPPI
BOARD OF WATER COMMISSIONERS
416 North State Street
Jackson, Mississippi 39201

CODED.

WATER WELL DRILLERS LOG
COASTAL DRILLING & SERVICE CO.

ROUTE 1 BOX 618

Jackson county well located

LANDOWNER: *Curtis Jones*

30537
BOLOXIE MISS

Description of formations encountered

from to

Olean Spring, Miss
(mailing address)

Top Soil	7	3
White Sand	3	60
Soft Clay	60	90
White Sand +	90	
Clay		185
Soft Clay	185	265
Light water sand	265	300
Hard Clay	300	400
Free water sand	400	440
Consolidated	440	440

WELL LOCATION:

sec. 2 T 7 N R 9 E 135
S W
(2) 7/8 miles NW *Hull Hill*
(distance) (direction) (nearest town)


WELL PURPOSE:

Home
(home, irrigation, municipal, industrial)

WELL COMPLETION DATA:

- (1) diameter (inches) 4" x 2"
- (2) total depth (feet) 440'
- (3) static water level (feet) 25 below top of ground.
- (4) casing PVC 425' (material) (depth)
4" x 2" (size) If telescope see back.
- (5) screen 15' 425' (length) (depth to top)
2" (size) PVC (material)
- (6) pump One 20 (HP) (yield gpm)
Ele Sub (type power)
- (7) electric log No (yes or no)
- (8) how well bottom plugged 2' back wash hole


DRILLERS REMARKS:

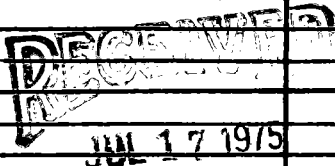

MISS. BD. OF WATER COMM

If well telescopes please sketch and show depths.

GROUND LEVEL

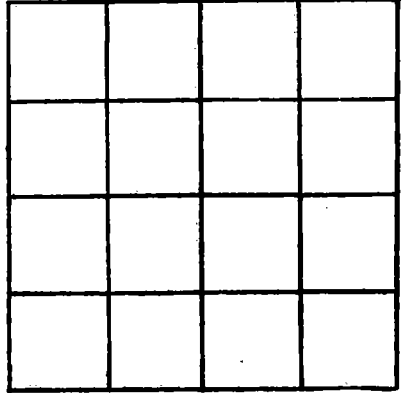

SECTION _____

Please indicate well location X.

ADDITIONAL INFORMATION

If more than one screen, show locations of each on sketch.