

JACKSON  
 N 482  
 7-19-78

MISSISSIPPI  
 BOARD OF WATER COMMISSIONERS  
 416 North State Street  
 Jackson, Mississippi 39201

CODED

WATER WELL DRILLERS LOG

July 19, 1978 Braden Pump Well Jackson  
 date well completed firm name county well located

LANDOWNER: Buck Ward

description of formations encountered

from to

Ocean Springs, Ms.  
 (mailing address)

Clay	0	18
Sand	18	60
White Clay	60	95
Blue Clay	95	250
Fine Sand	250	270
Blue	270	410
Fine Sand	410	430
Coarse Sand	430	460

WELL LOCATION:

sec. 3 T. 87 N. R. 8 E  
 S. W.  
 5 miles NW of Ocean Springs  
 (distance) (direction) (nearest town)

WELL PURPOSE: Home  
 (home, irrigation, municipal, industrial)

WELL COMPLETION DATA:

- (1) diameter (inches) 4" x 2"
- (2) total depth (feet) 460'
- (3) static water level (feet) 60' below top of ground
- (4) casing PVC, 4.50' (material) (depth)
- (5) screen 10' 4.50' (length) (depth to top)  
 2" PVC sch. 40 (size) (material)
- (6) pump 2500 HP, 30 (yield gpm)  
 electric (type power)
- (7) electric log No (yes or no)

CODED

(organization running log)

(8) how well bottom plugged sand  
 sand


DRILLERS REMARKS:

RECEIVED  
 AUG 11 1978

MISS. BD. OF WATER COMMISSIONERS

If well telescopes please sketch and show depths.

GROUND LEVEL

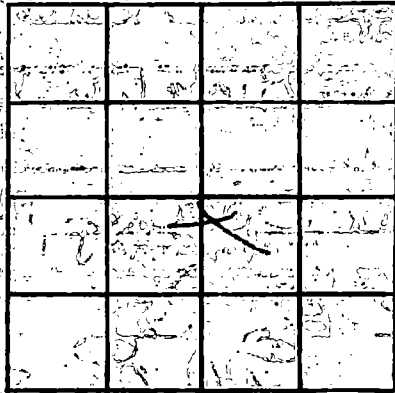

SECTION 3

Please indicate well location X.

ADDITIONAL INFORMATION

If more than one screen, show locations of each on sketch.