

JACKSON
N 483
8-30-78

MISSISSIPPI
 BOARD OF WATER COMMISSIONERS
 416 North State Street
 Jackson, Mississippi 39201

CODED

WATER WELL DRILLERS LOG

8-30
 date well completed

19 78 Coast Water Well, Inc.
 firm name

Jackson
 county well located

LANDOWNER: L. J. Stewart

description of formations encountered

from to

TOP soil	0	5
White Coarse sand	5	31
Blue Clay	31	58
White, Coarse sand	58	79
Blue Clay	79	89
Gray fine sand	89	141
Blue Clay	141	484
Gray fine sand	484	501
Gray med. sand	501	520
Grdy Coarse sand	520	540

Rt. Box 83
Osprey Springs, Miss. 39364
 (mailing address)

WELL LOCATION:

sec. 27 T. 7 S. R. 8 E. W. Spring
 (distance) miles in (direction) of (nearest town)

WELL PURPOSE: home
 (home, irrigation, municipal, industrial)

WELL COMPLETION DATA:

- diameter (inches) 4" x 2"
- total depth (feet) 540
- static water level (feet) 89' below top of ground.
- casing PVC 520
 (material) (depth)
4" x 2" (size) if telescope see back.
- screen 20' x 2" 520
 (length) (depth to top)
8" PVC
 (size) (material)
- pump 1 hp Subm. 26
 (HP) (yield gpm)
Elect
 (type power)
- electric log No.
 (yes or no)
 (organization running log)

CODED

(8) how well bottom plugged
Back Wash Valve


DRILLERS REMARKS:

RECEIVED

NOV - 9 1978

MISS. Bd. OF WATER COMMISSIONERS

If well telescopes please sketch and show depths.

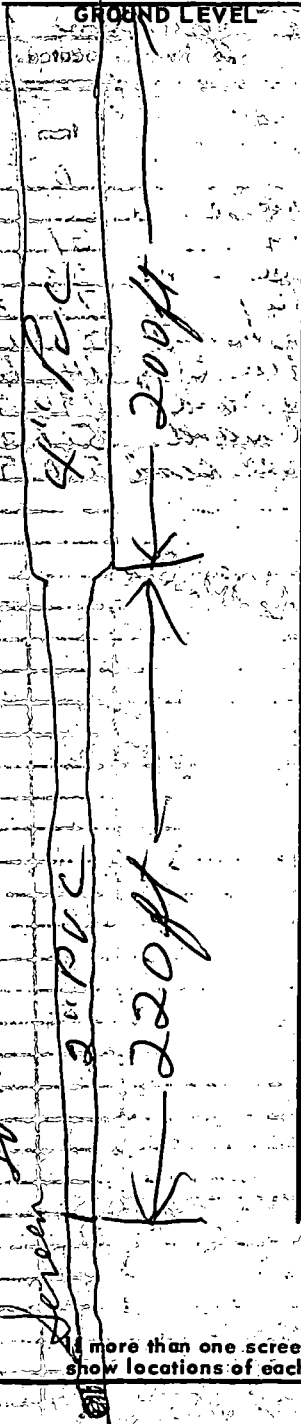

If more than one screen, show locations of each on sketch.

X			

SECTION 27

Please indicate well location X.

ADDITIONAL INFORMATION

Blank lined area for additional information.