

JACKSON
N 484
7-31-78

MISSISSIPPI
 BOARD OF WATER COMMISSIONERS **CODED**
 416 North State Street
 Jackson, Mississippi 39201

WATER WELL DRILLERS LOG

7-31-1978 date well completed
 78 Coast Water Users Soc. Inc. firm name
 Jackson county well located

LANDOWNER: Levy Johnson
4051 F.H. Hall
New Orleans, La. 70125
 (mailing address)

WELL LOCATION:
 sec. 3 T. 8 R. 8
3 miles S. East of Deer Springs
 (distance) (direction) (nearest town)

WELL PURPOSE: Home
 (home, irrigation, municipal, industrial)

WELL COMPLETION DATA:

(1) diameter (inches) 4" x 2"
 (2) total depth (feet) 500'
 (3) static water level (feet) 36' below top of ground.
 (4) casing PVC 480
 (material) (depth)
4 x 2" if telescope see back.
 (size)
 (5) screen 20' 480
 (length) (depth to top)
4 x 2 PVC
 (size) (material)
 (6) pump 3 H.P. 60 gal
 (HP) (yield gpm)
Elect.
 (type power)
 (7) electric log No.
 (yes or no)
 (organization running log)

(8) how well bottom plugged
back wash valve

description of formations encountered	from	to
Top soil	0	3
White fine sand	3	18
Blue Clay	18	34
White fine sand	34	69
Blue Clay	69	126
Gray fine sand	126	188
Blue Clay	188	205
Gray med. sand	205	226
Blue Clay	226	378
Gray fine sand	378	385
Blue Clay	385	470
Gray coarse sand	470	500


RECEIVED
 NOV - 9 1978

DRILLERS REMARKS:

MISS. BD. OF WATER COMM

If well telescopes please sketch and show depths.

GROUND LEVEL

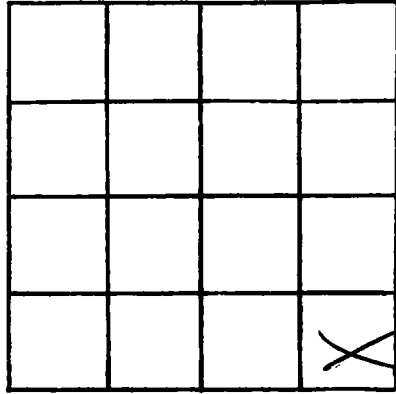

SECTION 3

Please indicate well location X.

ADDITIONAL INFORMATION

If more than one screen,
show locations of each on sketch.