

MISSISSIPPI DEPARTMENT OF NATURAL RESOURCES

Bureau of Land and Water Resources

Southport Mall

P.O. Box 10631

Jackson, Mississippi 39209

WATER WELL DRILLERS LOG

CODED

JACKSON
N 490

12/16/80
12/16/80

date well completed

firm name

county well located

Lyman Well Co

Jackson

LANDOWNER:

Dept. of Interior

description of formations encountered

from

to

Ntl PR Service, Gulf Island

SAND like with shell

0

80

NATIONAL Seashore (DAVIS Bogard)

grey clay

80

140

(mailing address)

SANDY clay

140

190

WELL LOCATION:

Blue clay

190

480

sec 33 T 7 N R 8 E

SAND, fine

480

560

2 miles SE of Ocean Springs

(distance)

(direction)

(nearest town)

WELL PURPOSE:

(home, irrigation, municipal, industrial)

WELL COMPLETION DATA:

(1) diameter (inches)

6 x 4

(2) total depth (feet)

560

(3) static water level (feet)

59

below above

(4) casing

steel

580

(material)

(depth)

6 x 4

(size)

if telescope see back.

(5) screen

30

530

(length)

(depth to top)

6"

(size)

SS

(material)

(6) pump

✓

✓

(HP)

(yield gpm)

✓

(type power)

(7) electric log

(yes or no)

(organization running log)

(8) how well bottom plugged

Backwash


DRILLERS REMARKS:

No pump AS of Now well produced 225-3pm with AIR

DEPT. OF NATURAL RESOURCES
BUREAU OF LAND & WATER RESOURCE
FEB 19 1981
RECEIVED

If well telescopes please sketch and show depths.

GROUND LEVEL

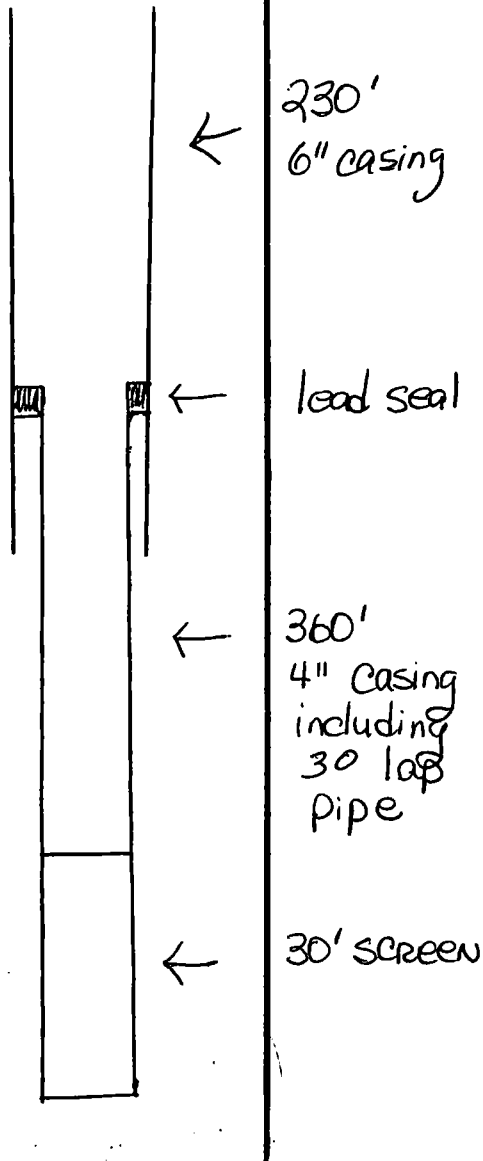

	X		

SECTION 32

Please indicate well location X.

ADDITIONAL INFORMATION

If more than one screen, show locations of each on sketch.