

MISSISSIPPI DEPARTMENT OF NATURAL RESOURCES

Bureau of Land and Water Resources

Southport Mall

P.O. Box 10631

Jackson, Mississippi 39209

CODED

WATER WELL DRILLERS LOG

JACKSON  
N 491  
  
3-12-81

3-12-81  
date well completed

19 Coast Water Well Sew. Inc.  
firm name

Jackson  
county well located

LANDOWNER Joseph H. Noel  
Kruger  
7101 Kruger Pl.  
Ocean Springs, Miss.  
(mailing address)

description of formations encountered	from	to
<u>Top soil</u>	<u>0</u>	<u>2</u>
<u>G. Clay</u>	<u>2</u>	<u>100</u>
<u>M. Sand</u>	<u>100'</u>	<u>120'</u>
<u>B. Clay</u>	<u>120'</u>	<u>215'</u>
<u>F. sand</u>	<u>215'</u>	<u>230'</u>
<u>B. Clay</u>	<u>230'</u>	<u>305'</u>
<u>F. sand</u>	<u>305'</u>	<u>320'</u>
<u>B. Clay</u>	<u>320'</u>	<u>425'</u>
<u>M. Sand</u>	<u>425'</u>	<u>480'</u>

WELL LOCATION:  
sec. 18 T. 7 N. R. 8 E.  
IN miles of Ocean Springs  
(distance) (direction) (nearest town)

WELL PURPOSE: None  
(home, irrigation, municipal, industrial)

WELL COMPLETION DATA:  
(1) diameter (inches) 2"  
(2) total depth (feet) 480'  
(3) static water level (feet) 70' below top of ground.  
(4) casing PVC 470'  
(material) (depth)  
2" If telescope see back.  
(size)  
(5) screen 10' 470'  
(length) (depth to top)  
2" PVC  
(size) (material)  
(6) pump 1 h.p. 7  
(HP) (yield gpm)  
Elect.  
(type power)  
(7) electric log No.  
(yes or no)  
(organization running log)

(8) how well bottom plugged  
back wash valve


DRILLERS REMARKS: \_\_\_\_\_

DEPT. OF NATURAL RESOURCES  
BUREAU OF LAND & WATER RESOURCES  
APR - 9 1981  
RECEIVED

If well telescopes please sketch and show depths.

12000

GROUND LEVEL

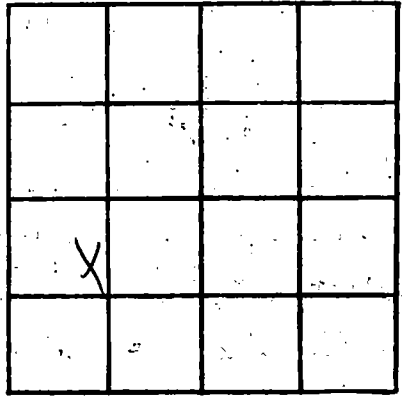

SECTION 18

Please indicate well location X.

ADDITIONAL INFORMATION

If more than one screen, show locations of each on sketch.