

MISSISSIPPI DEPARTMENT OF NATURAL RESOURCES

Bureau of Land and Water Resources

Southport Mall

P.O. Box 10631

Jackson, Mississippi 39209

CODED

WATER WELL DRILLERS LOG

JACKSON
N 494
2-9-81



2-9-81 date well completed
19 Cross Water Well Serv. Inc. firm name
Jackson county well located

LANDOWNER	description of formations encountered	from	to
Joseph Fountain Rt. 3 - Box 151	Top soil	0	2'
Ocean Springs, Miss. (mailing address) 39164	Red Coarse sand & Wood	2	60'
WELL LOCATION: NE SE sec. 1 T. 8 N. R. 8 E 5 miles SE of Ocean Springs (distance) (direction) (nearest town)	Blue Clay & streak of sand	60'	97'
WELL PURPOSE: Home (home, irrigation, municipal, industrial)	Blue Clay	97'	344'
WELL COMPLETION DATA:	Blue Clay & streak of sand	344'	370'
(1) diameter (inches) 2"	Blue Clay	370'	424'
(2) total depth (feet) 469'	Gray Coarse sand & sand gravel	424'	469'
(3) static water level (feet) 58' below top of ground.			
(4) casing PVC 459' (material) (depth) 2" (size) If telescope see back.			
(5) screen 10' 459' (length) (depth to top) 2" (size) PVC (material)			
(6) pump 1/2 HP 7 1/2 (HP) (yield gpm) Elect. (type power)			
(7) electric log No- (yes or no) (organization running log)			
(8) How well bottom plugged? Back wash blue			
DRILLERS REMARKS:			

DEPT. OF NATURAL RESOURCES
BUREAU OF LAND & WATER RESOURCES


APR - 7 1981

RECEIVED

If well telescopes please sketch and show depths.

0300

GROUND LEVEL

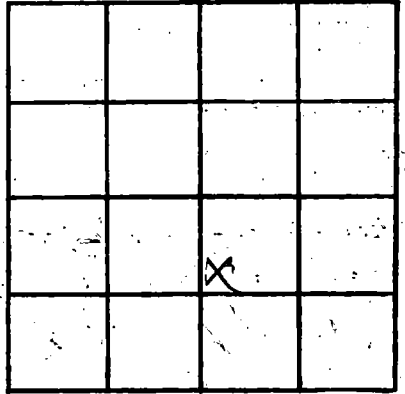

SECTION 1

Please indicate well location X.

ADDITIONAL INFORMATION

If more than one screen, show locations of each on sketch.