

MISSISSIPPI DEPARTMENT OF NATURAL RESOURCES

Bureau of Land and Water Resources

Southport Mall

P.O. Box 10631

Jackson, Mississippi 39209

WATER WELL DRILLERS LOG

JACKSON
N 495
2-3-81

2-3-81-19 date well completed
Coast Water Well Serv Inc. firm name
Jackson county well located

LANDOWNER: James Patterson
P.O. Box 215
Ocean Springs, Miss.
(mailing address)

WELL LOCATION:
sec. 11 T-8 N R-8 E
5 miles SE of Ocean Springs
(distance) (direction) (nearest town)

WELL PURPOSE: None
(home, irrigation, municipal, industrial)

WELL COMPLETION DATA:
(1) diameter (inches) 2"
(2) total depth (feet) 933'
(3) static water level (feet) 47' below top of ground.
(4) casing PVC 913'
(size) If telescope see back. (material) (depth)
(5) screen 20' 913'
(length) (depth to top) (size) (material)
(6) pump 1/2 h.p. 8-
(HP) (yield gpm)
Elec. (type power)
(7) electric log No. (yes or no)
(organization running log)
(8) how well bottom plugged back wash valve

description of formations encountered	from	to
Top soil	0	3'
A. Sand	3'	40"
B. Clay	40"	55"
C. sand	55'	117'
B. Clay	117'	330'
F. Sand	330'	350'
B. Clay	350'	900'
M. Sand	900'	933'

DEPT. OF NATURAL RESOURCES
BUREAU OF LAND & WATER RESOURCES


APR -7 1981

RECEIVED

DRILLERS REMARKS:

If well telescopes please sketch and show depths.

GROUND LEVEL

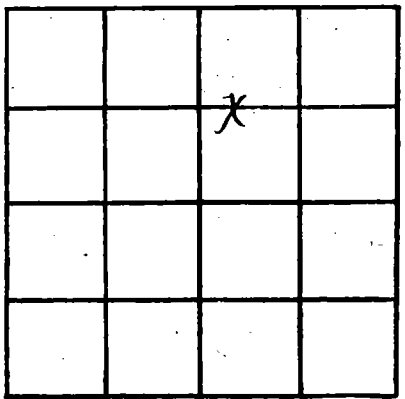

SECTION 11

Please indicate well location X.

ADDITIONAL INFORMATION



If more than one screen, show locations of each on sketch.