

Jackson
N496
4-1-81

MISSISSIPPI
 BOARD OF WATER COMMISSIONERS
 416 North State Street
 Jackson, Mississippi 39201

4

WATER WELL DRILLERS LOG

CODED

4-1-81 19 BRADEN PUMP AND WELL SERVICE, INC. Jackson
 date well completed firm name county well located

LANDOWNER:
Ocean Springs Seafood
EARL FAYARD
400 BEACH DR.
OCEAN SPRINGS, MS
 (mailing address)


WELL LOCATION:
 sec. 30 T. 7 N R. 8 E
 (distance) (direction) (nearest town)
17 miles of SPRINGS

WELL PURPOSE: industrial
 (home, irrigation, municipal, industrial)

WELL COMPLETION DATA:
 (1) diameter (inches) 6x4
 (2) total depth (feet) 940
 (3) static water level (feet) 20' below above top of ground.
 (4) casing PVC total
 (material) (depth)
6x4 if telescope see back.
 (size)
 (5) screen 30' 910'
 (length) (depth to top)
2 1/2" PVC underbar
 (size) (material)
 (6) pump 7 1/2 120
 (HP) (yield gpm)
230
 (type power)
 (7) electric log no
 (yes or no)
 (organization running log)
 (8) how well bottom plugged
2 1/2" B.W. valve

description of formations encountered	from	to
SAND	0	10
CLAY	10	20
SAND	20	90
CLAY	90	110
SAND	110	130
CLAY	130	140
SAND	140	150
CLAY	150	310
SAND	310	330
CLAY	330	380
SAND	380	385
CLAY	385	435
SAND	435	450
CLAY	450	478
SAND	478	480
CLAY	480	570
SAND	570	575
CLAY	575	628
SAND	628	645
CLAY	645	817
SAND	817	820
CLAY	820	830
SAND	830	835
CLAY	835	860
SAND	860	940

CODED

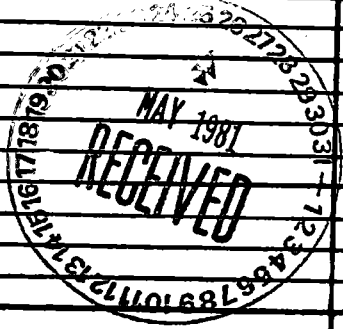

DRILLERS REMARKS:
no tail pipe

If well telescopes please sketch and show depths.

GROUND LEVEL

6" PVC
sch 40

200


4" PVC
sch 40

910

2 1/2" ~~DWC~~
underbar

SCREEN

940

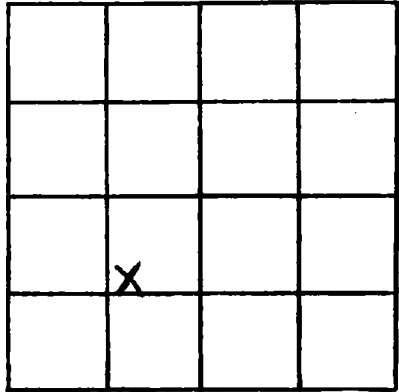

SECTION 30

Please indicate well location X.

ADDITIONAL INFORMATION

If more than one screen,
show locations of each on sketch.