

Jackson  
N 498  
5-27-81

MISSISSIPPI  
 BOARD OF WATER COMMISSIONERS  
 416 North State Street  
 Jackson, Mississippi 39201

CODED

WATER WELL DRILLERS LOG

BRADEN PUMP AND WELL SERVICE, INC. JACKSON  
 ROUTE 1, BOX 489  
 SAUCIER, MS 39574


S-28 1981  
 date well completed

county well located

LANDOWNER:  
 CLAY JOHNSON  
 SPANISH OAK TRI. PARK  
 Ocean Springs, MS 39564  
 (mailing address)

description of formations encountered	from to	
	ft	ft
Sand + gravel	0	100
CLAY	100	420
Sand	420	500

WELL LOCATION:

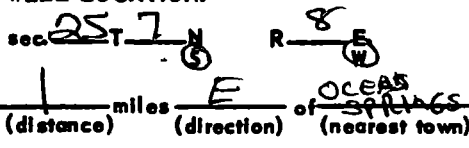

WELL PURPOSE: LEANER PUMP  
 (home, irrigation, municipal, industrial)

WELL COMPLETION DATA:

- (1) diameter (inches) 4 1/2
- (2) total depth (feet) 500'
- (3) static water level (feet) 20 <sup>below</sup> <sub>above</sub> top of ground
- (4) casing PVC total  
 (material) (depth)  
4 1/2 If telescope see back.  
 (size)
- (5) screen 20 480  
 (length) (depth to top)  
2" PVC underdrain  
 (size) (material)
- (6) pump 3 40  
 (HP) (yield gpm)  
230  
 (type power)
- (7) electric log NO  
 (yes or no)

(organization running log)

(8) how well bottom plugged  
2" sand shark

DRILLERS REMARKS:

NO tail pipe

CODED



If well telescopes please sketch and show depths.

GROUND LEVEL

4" PVC  
sch 40

4 x 2  
PVC casing

2" sch 40  
PVC

1" PVC  
casing

2" sand shark

100

470

570

X			

SECTION 25

Please indicate well location X.

ADDITIONAL INFORMATION

If more than one screen, show locations of each on sketch.