

JACKSON
 N 499
 7/22/81

MISSISSIPPI
 BOARD OF WATER COMMISSIONERS
 416 North State Street
 Jackson, Mississippi 39201

CODED

WATER WELL DRILLERS LOG
 BRADEN PUMP AND WELL SERVICE, INC.

JACKSON

4-22-81
 date well completed

19 ROUTE 1, BOX 489
 SAUCIER, MS 39574

county well located

LANDOWNER:
 LOON DUVALL JR
 530 BAYWOOD CIRCLE
 BILOXI, MS
 (mailing address)

description of formations encountered	from	to
CLAY	0	20
SAND	20	40
CLAY	40	60
SAND	60	65
CLAY	65	75
SAND	75	80
CLAY	80	85
SAND	85	100
CLAY	100	105
SAND	105	115
CLAY	115	200
SAND	200	205
CLAY	205	250
SAND	250	255
CLAY	255	260
SAND	260	300

WELL LOCATION:
 sec. 10 T 7 N R 9 E
 1/2 miles (distance) of St. Martin (nearest town)
 1/2 miles (distance) of DIBERVILLE

WELL PURPOSE: home
 (home, irrigation, municipal, industrial)

WELL COMPLETION DATA:

(1) diameter (inches) 4x2

(2) total depth (feet) 300

(3) static water level (feet) 45 below above top of ground

(4) casing PVC, total 4x2 (material) (depth) If telescope see back.

(5) screen 10, 280 (length) (depth to top)
 2" PVC underbar (size) (material)

(6) pump 1, 25 (HP) (yield gpm)
 230 (type power)

(7) electric log NO (yes or no)
 (organization running log)

(8) how well bottom plugged 2" SAND SHARK

DEPT. OF NATURAL RESOURCES
 BUREAU OF LAND & WATER RESOURCES

AUG 25 1981

RECEIVED
 AUG 1981
 RECEIVED

DRILLERS REMARKS:
 10' TAIL PIPE

If well telescopes please sketch and show depths.

GROUND LEVEL

4" sch 40
PVC

4x2 PVC
BUSHING

2" SCH 40
PVC

2" 10' PVC
UNDERBAR
SCREEN


2" SAND
SHARK

200

280

290

300

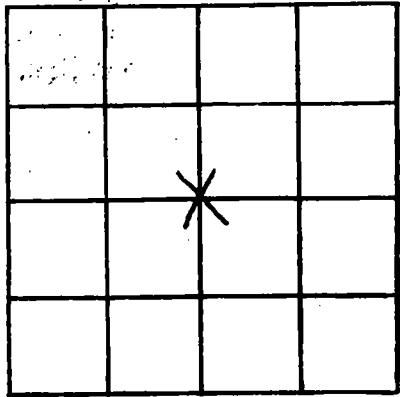

SECTION 11e

Please indicate well location X.

ADDITIONAL INFORMATION

If more than one screen, show locations of each on sketch.