

MISSISSIPPI DEPARTMENT OF NATURAL RESOURCES

Bureau of Land and Water Resources

Southport Mall

P.O. Box 10631

Jackson, Mississippi 39209

WATER WELL DRILLERS LOG

CODED

JACKSON  
N 505  
1182

Nov. 19 82 date well completed GR RIVER DRILLING SER. firm name JACKSON county well located

LANDOWNER: Well No. 1R  
SUBURBAN LITHTIES  
OCEAN SPRINGS, MISS  
(mailing address)

description of formations encountered	from	to
TOP SOIL	0	3
CLAY + SAND STRATA	3	50
SAND	50	110
CLAY + SANDY STRATA	110	201
CLAY	201	416
SANDY CLAY	416	455
SAND	455	483
CLAY	483	517

WELL LOCATION: SE 1/4 NE 1/4 NW 1/4 SE 1/4  
sec. 18 T 7 N R 8 E  
\_\_\_\_\_ miles \_\_\_\_\_ of \_\_\_\_\_  
(distance) (direction) (nearest town)

WELL PURPOSE:  
(home, irrigation, municipal, industrial)

- WELL COMPLETION DATA:
- (1) diameter (inches) 10 3/4"
  - (2) total depth (feet) 482 FT.
  - (3) static water level (feet) 91.02 below top of ground.
  - (4) casing Steel 447  
(material) (depth)  
10 3/4" if telescope see back.  
(size)
  - (5) screen 22.50 459.50 FT.  
(length) (depth to top)  
6 204 S.S. (.016)  
(size) (material)
  - (6) pump 25 254  
(HP) (yield gpm)  
Elect.  
(type power)
  - (7) electric log Yes  
(yes or no)  
Miss. Geol. Survey  
(organization running log)
  - (8) how well bottom plugged BACK  
WASH VALVE

CODE

DEPT. OF NATURAL RESOURCES  
BUREAU OF LAND & WATER RESOURCES


DEC - 1 1982

RECEIVED

DRILLERS REMARKS:

If well telescopes please sketch and show depths.

GROUND LEVEL

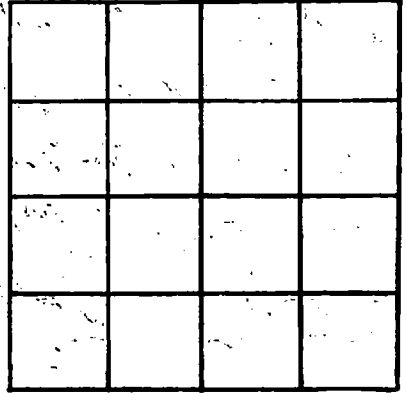

SECTION \_\_\_\_\_

Please indicate well location X.

ADDITIONAL INFORMATION

If more than one screen, show locations of each on sketch.