

MISSISSIPPI DEPARTMENT OF NATURAL RESOURCES

Bureau of Land and Water Resources

Southport Mall

P.O. Box 10631

Jackson, Mississippi 39209

WATER WELL DRILLERS LOG

CODED

N 508
 Jackson
 9-2-83

9-2 1983 Coast Water Well Sew. Jackson
 date well completed firm name county well located

LANDOWNER: Richard Morrow
Rt 5 - Box 625
Ocean Springs Miss
 (mailing address) 39164
 sec. 1 T. 7 R. 2
4 miles N of OCEAN SPRINGS
 (distance) (direction) (nearest town)

WELL LOCATION:
 (home, irrigation, municipal, industrial)

WELL PURPOSE: Home

WELL COMPLETION DATA:
 (1) diameter (inches) 4" x 2"
 (2) total depth (feet) 354'
 (3) static water level (feet) 25' below top of ground.
 (4) casing PVC 334'
 (material) (depth)
4" x 2" If telescope see back.
 (size)
 (5) screen 20' 334'
 (length) (depth to top)
4" x 2" PVC
 (size) (material)
 (6) pump 1/2 HP 30
 (HP) (yield gpm)
Electric
 (type power)
 (7) electric log No.
 (yes or no)
 (organization running log)

| description of formations encountered | from | to |
|---------------------------------------|------|------|
| Top soil | 0' | 1' |
| Red Clay | 1' | 14' |
| Blue Clay | 14' | 21' |
| Blue Clay & Shale | 21' | 36' |
| Gray Coarse sand | 36' | 46' |
| Blue Clay | 46' | 322' |
| Gray Coarse sand | 322' | 345' |
| Blue Clay | 345' | 354' |

(8) how well bottom plugged Back water valve

DRILLERS REMARKS:


DEPT. OF NATURAL RESOURCES
 BUREAU OF LAND & WATER RESOURCES

OCT 14 1983

RECEIVED

If well telescopes please sketch and show depths.

GROUND LEVEL

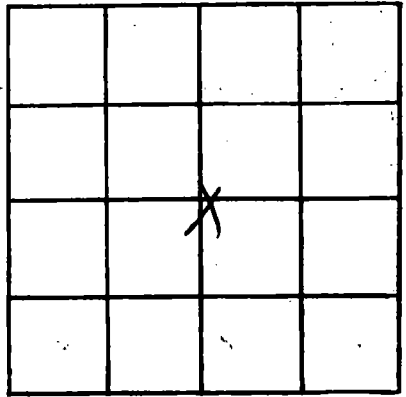

SECTION 1

Please indicate well location X.

ADDITIONAL INFORMATION

If more than one screen, show locations of each on sketch.