

MISSISSIPPI DEPARTMENT OF NATURAL RESOURCES

Bureau of Land and Water Resources

Southport Mall

P.O. Box 10631

Jackson, Mississippi 39209

WATER WELL DRILLERS LOG

CODED

JACKSON
N 513

8-24 1984 Coast Water Well Sw. Jackson
date well completed firm name county well located

LANDOWNER: Harry Cozart
Rt 3 - Box 197
Ocean Springs, Miss.
(mailing address)

WELL LOCATION:
sec. 2 T 8 N R 8 E
3 miles SE of Ocean Springs
(distance) (direction) (nearest town)

WELL PURPOSE: Home
(home, irrigation, municipal, industrial)

WELL COMPLETION DATA:

(1) diameter (inches) 2"
(2) total depth (feet) 940'
(3) static water level (feet) 18' below top of ground
(4) casing PVC, 920'
(size) (material) (depth)
2" if telescope see back.
(5) screen 20', 920'
(length) (depth to top)
2" PVC
(size) (material)
(6) pump 1/2 10
(HP) (yield gpm)
elec
(type power)
(7) electric log NO
(yes or no)

(organization running log)

(8) how well bottom plugged Backwash valve


DRILLERS REMARKS:

description of formations encountered	from	to
<u>Top Soil</u>	<u>0</u>	<u>2</u>
<u>Red Coarse Sand</u>	<u>2</u>	<u>26</u>
<u>Blue Clay</u>	<u>26</u>	<u>190</u>
<u>Blue Clay & Sand</u>	<u>190</u>	<u>193</u>
<u>Blue Clay</u>	<u>193</u>	<u>234</u>
<u>Blue Fine Sand</u>	<u>234</u>	<u>246</u>
<u>Blue Clay & Sand</u>	<u>246</u>	<u>291</u>
<u>Blue Clay</u>	<u>291</u>	<u>380</u>
<u>Blue Clay & Nyster Shell</u>	<u>380</u>	<u>435</u>
<u>Blue Clay</u>	<u>435</u>	<u>451</u>
<u>Blue Clay & Shp. Shell</u>	<u>451</u>	<u>558</u>
<u>Blue Clay</u>	<u>558</u>	<u>592</u>
<u>Rock</u>	<u>592</u>	<u>592</u>
<u>Blue Clay</u>	<u>592</u>	<u>612</u>
<u>Rock</u>	<u>612</u>	<u>612</u>
<u>Blue Clay</u>	<u>612</u>	<u>684</u>
<u>Blue Fine Sand</u>	<u>684</u>	<u>687</u>
<u>Blue Clay</u>	<u>687</u>	<u>751</u>
<u>Blue Clay & Nyster Shell</u>	<u>751</u>	<u>779</u>
<u>Rock</u>	<u>779</u>	<u>779</u>
<u>Blue Clay & Nyster Shell</u>	<u>779</u>	<u>846</u>
<u>Blue Clay</u>	<u>846</u>	<u>903</u>
<u>Gray Coarse Sand</u>	<u>903</u>	<u>930</u>
<u>Blue Clay</u>	<u>930</u>	<u>940</u>

DEPT. OF NATURAL RESOURCES
BUREAU OF LAND AND WATER RESOURCES
OCT 12 1984
RECEIVED

If well telescopes please sketch and show depths.

GROUND LEVEL

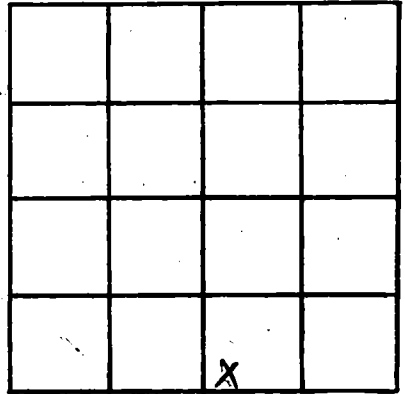

SECTION 2

Please indicate well location X.

ADDITIONAL INFORMATION

If more than one screen, show locations of each on sketch.