

JACKSON
N 515

MISSISSIPPI DEPARTMENT OF NATURAL RESOURCES

Bureau of Land and Water Resources

Southport Mall

P.O. Box 10631

CODED

Jackson, Mississippi 39209

WATER WELL DRILLERS LOG
COASTAL DRILLING & SERVICE CO.

12/10/83
date well completed

ROUTE 1 BOX 618

firm name

BILOXI, MISS 39532

Jackson
county well located

LANDOWNER: Richard Ward

description of formations encountered

from to

Rt 6

top soil

1 3

Ocean Springs, MS
(mailing address)

Soft Blue Clay

3 15

Red Sand

15 30

Soft Blue Clay

30 65

Coarse white sand

65 110

Soft Blue Clay

110 240

hard Blue Clay

240 360

grey water sand

360 375

grey water sand

375 415

WELL LOCATION:

sect 35 T 7 N R 8 E S W

Moss Bluff
(distance) (direction) (nearest town)

WELL PURPOSE:

home
(home, irrigation, municipal, industrial)

WELL COMPLETION DATA:

(1) diameter (inches) 4 1/2"

(2) total depth (feet) 415'

(3) static water level (feet) 20' below above top of ground.

(4) casing galv 400'
(material) (depth)
4 1/2"
(size) if telescope see back.

(5) screen 15' 400'
(length) (depth to top)

2" galv
(size) (material)

(6) pump 1/2 hp 20
(HP) (yield gpm)

ele
(type power)

(7) electric log no
(yes or no)

(organization running log)

(8) how well bottom plugged
2" back wash water

DRILLERS REMARKS: 19-B

CODED

DEPT. OF NATURAL RESOURCES
BUREAU OF LAND & WATER RESOURCES

NOV 8 1984

RECEIVED

If well telescopes please sketch and show depths.


GROUND LEVEL

160' - 4" PVC casing
Sch 40

240' - 2" PVC casing
Sch 40

15' - 2" PVC screen

2" back wash valve
19-B

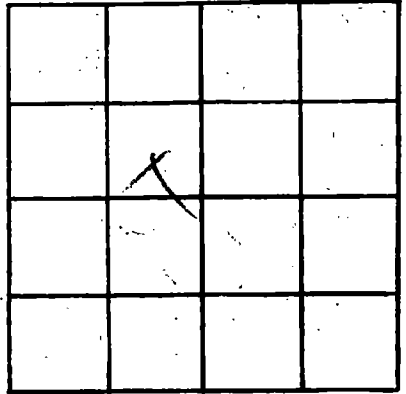

SECTION _____

Please indicate well location X.

ADDITIONAL INFORMATION

If more than one screen, show locations of each on sketch.