

MISSISSIPPI DEPARTMENT OF NATURAL RESOURCES

Bureau of Land and Water Resources

#6

Southport Mall

P.O. Box 10631

CODED

Jackson, Mississippi 39209

WATER WELL DRILLERS LOG

N. 518
 JACKSON

12-10-84
 date well completed

Cross Water Well Saw Jackson
 firm name

Jackson
 county well located

LANDOWNER: P.O. Perez
P.O. Box 157, Belle Chasse
Louisiana 70037
 (mailing address)

WELL LOCATION:
 sec 10 T 8 N R 8 E
2 miles SE of OCEAN SPRINGS
 (distance) (direction) (nearest town)

WELL PURPOSE: None
 (home, irrigation, municipal, industrial)

WELL COMPLETION DATA:

(1) diameter (inches) 4"

(2) total depth (feet) 509'

(3) static water level (feet) 60 below top of ground.

(4) casing PVC, 489'
 (material) (depth)
4" If telescope see back.
 (size)

(5) screen 20', 489
 (length) (depth to top)
4", PVC
 (size) (material)

(6) pump 3 h.p., 55
 (HP) (yield gpm)
Elect.
 (type power)

(7) electric log No
 (yes or no)

 (organization running log)

(8) back well bottom plugged

description of formations encountered	from	to
Red Clay	0	5'
White sand	5'	69'
Blue Clay (strip sand)	69'	150'
White coarse sand	150'	210'
Blue Clay	210'	310'
Blue Clay - Shell	310'	387'
Fine sand	387'	415'
Blue Clay	415'	458'
Fine sand	458'	473'
Coarse sand	473'	509'
(No Tail Pipe)		

RECEIVED


APR 2 - 1985

Department of Natural Resources
 Bureau of Land & Water Resources

DRILLERS REMARKS: _____

If well telescopes please sketch and show depths.

GROUND LEVEL

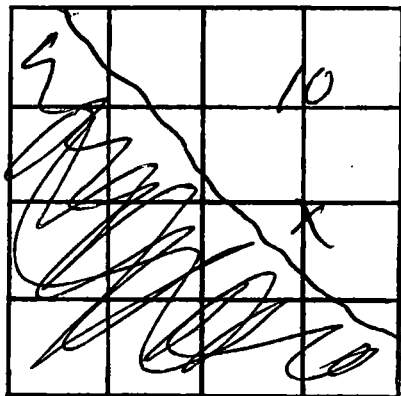

SECTION _____

Please indicate well location X.

ADDITIONAL INFORMATION

If more than one screen, show locations of each on sketch.