

MISSISSIPPI DEPARTMENT OF NATURAL RESOURCES

Bureau of Land and Water Resources

Southport Mall

P.O. Box 10631 CODED

Jackson, Mississippi 39209

WATER WELL DRILLERS LOG

N519
(Cometary Well)

12-14-1984 84 Coast Water Well Sew. Jackson
date well completed film name county well located

LANDOWNER: Charles W. Amundson
Henry 90,
Ocean Springs, Miss
(mailing address) 32564

WELL LOCATION:
sec. 26 T. 7 N. R. 8 E
IN miles (distance) of Spring (direction) of Spring (nearest town)

WELL PURPOSE:
(home, irrigation, municipal, industrial)

WELL COMPLETION DATA:

- (1) diameter (inches) 2"
- (2) total depth (feet) 495'
- (3) static water level (feet) 50' below top of ground.
- (4) casing PVC (material), 485' (depth)
- (5) screen 2" (size) if telescope see back. 10' (length), 485' (depth to top)
- (6) pump 1/2 HP (HP), 6 (yield gpm)
- (7) electric log Elect. (type power)
- (7) electric log No (yes or no)
- (8) Back Wash Valve (organization running log)

Description of formations encountered	from	to
<u>Sandy Top soil</u>	<u>0</u>	<u>10'</u>
<u>Gray Clay</u>	<u>10'</u>	<u>75'</u>
<u>Med Sand</u>	<u>75'</u>	<u>83'</u>
<u>Blue Clay</u>	<u>83'</u>	<u>105'</u>
<u>F Sand</u>	<u>105'</u>	<u>115'</u>
<u>Blue Clay</u>	<u>115'</u>	<u>120'</u>
<u>Fine Sand</u>	<u>120'</u>	<u>133'</u>
<u>Blue Clay</u>	<u>133'</u>	<u>195'</u>
<u>Fine Sand</u>	<u>195'</u>	<u>220'</u>
<u>Blue Clay</u>	<u>220'</u>	<u>285'</u>
<u>Fine Sand</u>	<u>285'</u>	<u>305'</u>
<u>Blue Clay</u>	<u>305'</u>	<u>455'</u>
<u>Med Sand</u>	<u>455'</u>	<u>495'</u>

RECEIVED


APR 2 - 1985

Department of Natural Resources
Bureau of Land & Water Resources

DRILLERS REMARKS:

If well telescopes please sketch and show depths.

GROUND LEVEL

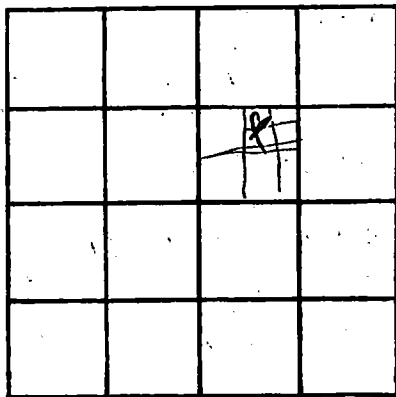

SECTION 26

Please indicate well location X.

ADDITIONAL INFORMATION

If more than one screen,
show locations of each on sketch.