

MISSISSIPPI DEPARTMENT OF NATURAL RESOURCES

Bureau of Land and Water Resources

Southport Mall

P.O. Box 10631

Jackson, Mississippi 39209

WATER WELL DRILLERS LOG

CODED

Jackson
N 527

Jan 20 86 19 Coast Waterwell Jackson
date well completed firm name county well located

LANDOWNER:	description of formations encountered	from	to
<u>Schaffert & Sons</u>			
<u>666 Adams Ave</u>			
<u>Memphis TN</u> (mailing address)	<u>Top Soil</u>	<u>0'</u>	<u>5'</u>
WELL LOCATION: sec. <u>13</u> T. <u>7</u> N. R. <u>8</u> E <u>1</u> miles <u>N/E</u> of <u>OCEAN SPRINGS</u> (distance) (direction) (nearest town)	<u>Blue Clay</u>	<u>5'</u>	<u>62'</u>
WELL PURPOSE: <u>Boat</u> (home, irrigation, municipal, industrial)	<u>white coarse sand & gravel</u>	<u>62'</u>	<u>80'</u>
WELL COMPLETION DATA: (1) diameter (inches) <u>2"</u>	<u>white coarse sand</u>	<u>80'</u>	<u>103'</u>
(2) total depth (feet) <u>107'</u>	<u>Blue Clay</u>	<u>103'</u>	<u>107'</u>
(3) static water level (feet) <u>flow</u> below above top of ground.			
(4) casing <u>PVC</u> (<u>92'</u>) (material) (depth)			
<u>2"</u> If telescope see back. (size)			
(5) screen <u>10</u> (<u>102</u>) (length) (depth to top)			
<u>2"</u> (<u>PVC</u>) (size) (material)			
(6) pump _____ (HP) _____ (yield gpm)			
(type power)			
(7) electric log <u>no</u> (yes or no)			
(organization running log)			
(8) how well bottom plugged <u>bottom was</u>			
DRILLERS REMARKS: <u>5ft 2" cast pipe</u>			


CODED

RECEIVED
MAR 6 1986

Department of Natural Resources
Bureau of Land & Water Resources

If well telescopes please sketch and show depths.

GROUND LEVEL

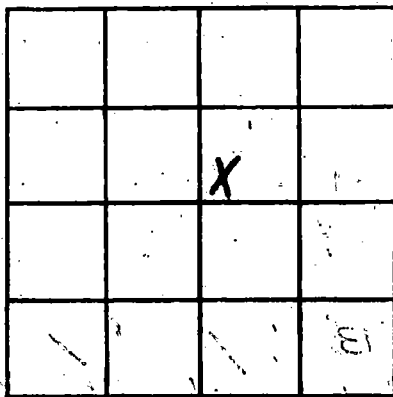

SECTION 13

Please indicate well location X.

ADDITIONAL INFORMATION

If more than one screen, show locations of each on sketch.