

MISSISSIPPI DEPARTMENT OF NATURAL RESOURCES
 Bureau of Land and Water Resources
 Southport Mall
 P.O. Box 10631
 Jackson, Mississippi 39209
WATER WELL DRILLERS LOG

Jackson
N528

CODED

11/20/85

Jackson

date well completed

firm name

county well located

LANDOWNER: Leond Cooper
Semon Rd
Ocean Springs, ms
 (mailing address)

description of formations encountered	from	to
top soil	1	15
red clay	15	200
soft blue clay	200	385
good water sand	385	420
hard blue clay	420	700
red clay	700	880
blue clay	880	1000
fine water sand	1000	1020
good water sand	1020	1050

WELL LOCATION:
 sec. 21 T. 7 N R. 8 E
 S W
Semon Rd of
 (distance) (direction) (nearest town)

WELL PURPOSE: home
 (home, irrigation, municipal, industrial)

WELL COMPLETION DATA:

- (1) diameter (inches) 2"
- (2) total depth (feet) 1050
- (3) static water level (feet) 15 below above top of ground.
- (4) casing pvc, 1040
 (material) (depth)
 (size) if telescope see back.
- (5) screen 20, 1040
 (length) (depth to top)
2", pvc
 (size) (material)
- (6) pump 1, 10
 (HP) (yield gpm)
elc.
 (type power)
- (7) electric log no
 (yes or no)
 (organization running log)
- (8) how well bottom plugged 2" back
wash valve

CODED


RECEIVED
 MAY 19 1986

DRILLERS REMARKS:

Department of Natural Resources
 Bureau of Land & Water Resources

If well telescopes please sketch and show depths.

GROUND LEVEL

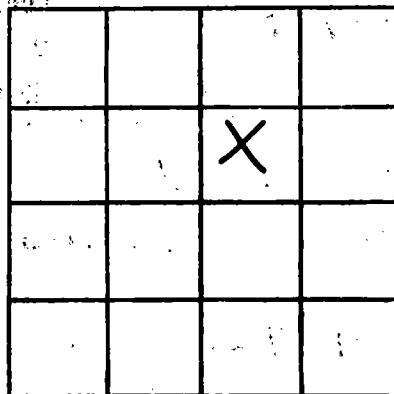

SECTION _____

Please indicate well location X.

ADDITIONAL INFORMATION

If more than one screen, show locations of each on sketch.