

MISSISSIPPI DEPARTMENT OF NATURAL RESOURCES

Bureau of Land and Water Resources

Southport Mall

P.O. Box 10631

Jackson, Mississippi 39209

WATER WELL DRILLERS LOG

CODED

JACKSON
N 529

7-16 1986 Coast Water Well Sew. Jackson
date well completed firm name county well located

LANDOWNER: <u>Productive Inc.</u>	Description of formations encountered	from	to
<u>PO Box 446</u>	<u>TOP SOIL</u>	<u>0</u>	<u>3</u>
<u>Ocean Springs ms.</u> (mailing address)	<u>RED CLAY</u>	<u>3</u>	<u>11</u>
WELL LOCATION: sec. <u>13</u> T. <u>7</u> N. R. <u>8</u> E <u>2</u> miles <u>NE</u> of <u>OCEAN SPRINGS</u> (distance) (direction) (nearest town)	<u>BLUE CLAY</u>	<u>11</u>	<u>75</u>
WELL PURPOSE: <u>Home</u> (home, irrigation, municipal, industrial)	<u>WHITE COARSE SAND</u>	<u>75</u>	<u>108</u>
WELL COMPLETION DATA:	<u>BLUE CLAY</u>	<u>108</u>	<u>260</u>
(1) diameter (inches) <u>2"</u>	<u>BLUE CLAY w/STREAKS OF SAND</u>	<u>260</u>	<u>330</u>
(2) total depth (feet) <u>362'</u>	<u>GRAY COARSE SAND</u>	<u>330</u>	<u>357</u>
(3) static water level (feet) <u>59'</u> ^{below} / _{above} top of ground.	<u>BLUE CLAY</u>	<u>357</u>	<u>362</u>
(4) casing <u>PVC</u> <u>332'</u> (material) (depth)			
<u>2"</u> (size) If telescope see back.			
(5) screen <u>20'</u> <u>332'</u> (length) (depth to top)			
<u>2"</u> <u>PVC.</u> (size) (material)			
(6) pump <u>1</u> <u>7</u> (HP) (yield gpm)			
<u>Elec.</u> (type power)			
(7) electric log <u>No</u> (yes or no)			
(organization running log)			
(8) how well bottom plugged <u>Backwash</u> <u>value: tailpipe</u>			
DRILLERS REMARKS: <u>5' 2" PVC tailpipe on bottom</u>			


CODED

RECEIVED
AUG 26 1986

Department of Natural Resources
Bureau of Land & Water Resources

If well telescopes please sketch and show depths.

GROUND LEVEL

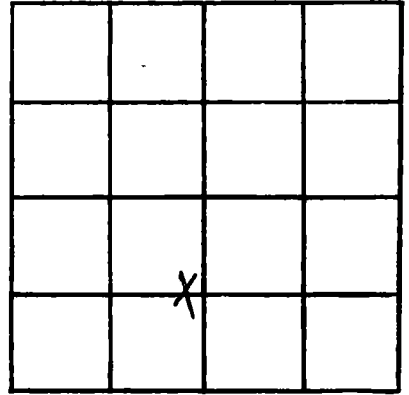

SECTION 13

Please indicate well location X.

ADDITIONAL INFORMATION

If more than one screen, show locations of each on sketch.