

JACKSON MISSISSIPPI BOARD OF WATER COMMISSIONERS
 1285 1644 1791 2161 2214 3092 3992 4474 4476
WATER WELL DRILLERS LOG

CODED

Date: 3-20-63, 1963, Driller: C. T. Switzer Well County: JACKSON
 (Name)

(1) Owner of Land: Carl Watworks
 (Name)
Camden Rd. Ocean Springs
 (Address)

(2) Location: 1/4, 1/4, Sec. 21 T 7 R 8
 miles of
 (distance) (direction) (Nearest Town)

(3) Topography: (Hilly) (Flat) (Level)

(4) Purpose of Well: Commercial
 (Domestic Irrigation
 Municipal, Industrial, Other)

Description & Color of Materials Sand, Clay, Red Clay, Shell, etc.	Thick- ness Feet	Depth Feet
<u>Sandy clay</u>	<u>00</u>	<u>23</u>
<u>Clay</u>	<u>23</u>	<u>40</u>
<u>Sand</u>	<u>40</u>	<u>114</u>
<u>Clay</u>	<u>114</u>	<u>207</u>
<u>Sand</u>	<u>207</u>	<u>235</u>
<u>Clay</u>	<u>235</u>	<u>257</u>
<u>Sand</u>	<u>257</u>	<u>275</u>
<u>Clay</u>	<u>275</u>	<u>403</u>
<u>Sand</u>	<u>403</u>	<u>493</u>

Information upon completion of well:

(1) Diameter 6 1/8 inches.

(2) Total Depth 493 feet.

(3) Water Level 8' feet below top of ground.

(4) Cased to 493', Size 6 1/8


(5) Screen: Size 6", Length 10'

(6) Were any formations sealed against pollution?
 yes, no.

If YES depth of formation _____

Why: Health Dept. requirements

Drillers Remarks: _____

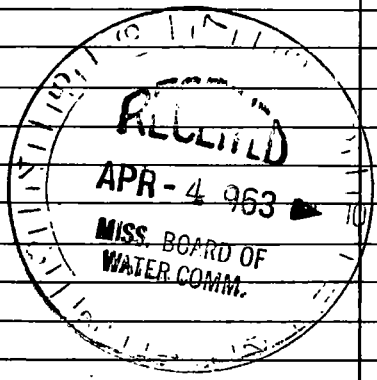

(Use Back Side)

Well No.

Handwritten text at the top of the page, possibly a title or header.

Handwritten text in the upper middle section of the page.

Handwritten text in the upper right section of the page.

Handwritten text in the middle right section of the page.

Handwritten text in the lower right section of the page.

Handwritten text in the lower middle section of the page.

Handwritten text at the bottom of the page, possibly a signature or footer.