

MISSISSIPPI DEPARTMENT OF ENVIRONMENTAL QUALITY
Bureau of Land and Water Resources

P. O. Box 10631
Jackson, MS 39289-0631
WATER WELL DRILLERS LOG

COUNTY WELL LOCATED <i>Jackson</i>	
WELL NUMBER <i>N055ST</i>	CODED <input checked="" type="checkbox"/>
DATE WELL COMPLETED <i>10-16-92</i>	

PERMIT NUMBER
NAME OF DRILLING FIRM <i>Coast Water Well, Ser. Inc.</i>

NAME & MAILING ADDRESS OF LANDOWNER <i>Glen Woods</i>			
WELL LOCATION: SEC <u>1</u> TOWNSHIP <u>8 N</u> RANGE <u>8 E</u>			
DISTANCE <u>2</u> Miles	DIRECTION <u>S</u>	NEAREST TOWN <u>Fountain Bluff</u>	
OTHER LANDMARK			
WELL PURPOSE: <input checked="" type="checkbox"/> Home, Irrigation, Municipal, Industrial, Fish Pond, etc.			

PUMP DATA		
PUMP TYPE (Circle One): Submersible, Turbine, <input checked="" type="radio"/> Jet, Flowing Well, Other (Describe) _____		
POWER TYPE (Circle One): <input checked="" type="radio"/> Electric, Tractor, Diesel, Gasoline, Butane, Other (Describe) _____ H/P <u>1</u>		
Pump Capacity (GPM) <u>10</u>	No. of Stages <u>2</u>	Setting Depth _____ FT.
PUMP TEST Well yielded _____ GPM with a drawdown of _____ ft. after _____ hours of pumping		

WELL DATA		
Well Depth <u>351'</u>	Casing Diameter (In.) <u>2"</u>	Casing Length (Ft.) <u>338'</u>
Type of Casing <u>PVC</u>	Hole Depth <u>351'</u>	Depth to Static Water Level <u>30'</u>
TYPE OF COMPLETION: (Circle One or More): <input checked="" type="checkbox"/> Gravel Packed, <input type="checkbox"/> Underreamed, <input type="checkbox"/> Telescoped, <input type="checkbox"/> Natural Development, <input type="checkbox"/> Open Hole, <input type="checkbox"/> Other (Describe) _____		
Top of Lap Pipe or Reduction in Casing FEET IF TELESCOPED OR MORE THAN ONE SCREEN: USE BACK PAGE		

LOG DATA	
TYPE OF LOG RUN (Circle One): Electric, Gamma Ray, Density, Sonic, Neutron, Other (Describe) _____ <input checked="" type="radio"/> No Log Run	
Name of Organization Running Log	

SCREEN DATA		
Diameter - Inches <u>2"</u>	Length - Feet <u>10'</u>	Slot Size - Inches <u>.008"</u>
Screen Type <u>PVC</u>	Depth to Bottom - Feet <u>348'</u>	


GEOLOGIC DATA (Office Use Only)			
Surface Elev.	Geologic Unit	Unit Thickness	Depth to Top
Subs. SWL	Date	Analysis	Aquifer Test
Driller's Remarks			

DESCRIPTION OF FORMATIONS ENCOUNTERED	FROM	TO
<i>Top soil</i>	<i>0</i>	<i>2</i>
<i>Blue Clay</i>	<i>2</i>	<i>50</i>
<i>Coarse sand</i>	<i>50</i>	<i>70</i>
<i>Blue Clay</i>	<i>70</i>	<i>90</i>
<i>Mid. sand</i>	<i>90</i>	<i>125</i>
<i>Blue Clay & sand shell</i>	<i>125</i>	<i>330</i>
<i>Coarse sand</i>	<i>330</i>	<i>348</i>
<i>Blue Clay</i>	<i>348</i>	<i>351</i>

FORMATIONS (Continued)	FROM	TO
RECEIVED		
JAN 27 1993		
Dept. of Environmental Quality Office of Land & Water Resources		
IF MORE SPACE IS NEEDED, USE BACK		

If well telescopes please sketch and show depths.

GROUND LEVEL

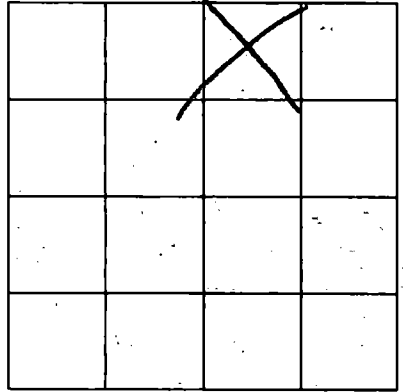

SECTION _____

Please indicate well location X.

ADDITIONAL INFORMATION

A series of horizontal lines for writing additional information.

If more than one screen, show location of each on sketch.