

MISSISSIPPI DEPARTMENT OF NATURAL RESOURCES

Bureau of Land and Water Resources

Southport Mall

P.O. Box 10631

3

Jackson, Mississippi 39209

WATER WELL DRILLERS LOG

Jackson
N 604

8-13

1984

Coast Water Well Sew. Jackson

date well completed

firm name

county well located

LANDOWNER:

Legal Rafferty
P.O. Box 58 P

description of formations encountered

from

to

Ocean Springs, Miss.
(mailing address) 39564

Sandy Top soil 0 25'

Blue Clay 25' 39'

Coarse sand 39' 72'

Blue Clay 72' 80'

Coarse sand 80' 195'

WELL LOCATION:

sec. 10 T. 8 N. R. 8 E
3 miles SE of OCEAN SPRINGS
(distance) (direction) (nearest town)

WELL PURPOSE:

(home, irrigation, municipal, industrial)

Blue Clay 195' 395'

WELL COMPLETION DATA:

(1) diameter (inches) 2"

(2) total depth (feet) 510'

(3) static water level (feet) 90' below top of ground.

(4) casing PVC, 490' (material) (depth)

2" (size) if telescope see back.

(5) screen 20' (length), 490' (depth to top)

2" (size), PVC (material)

(6) pump 1/2 HP, 6- (HP) (yield gpm)

elect. (type power)

(7) electric log No. (yes or no)

(organization running log)

(8) how well bottom plugged back wash valve

Fine sand 395' 415'

Blue Clay 415' 478'

Med. Sand 478' 493'

Blue Clay 493' 495'

Med. Sand 495' 508'


5 ft. 2" Tail Pipe 510'

DEPT. OF NATURAL RESOURCES
BUREAU OF LAND & WATER RESOURCES
RECEIVED
OCT 12 1984

DRILLERS REMARKS:

If well telescopes please sketch and show depths.

GROUND LEVEL

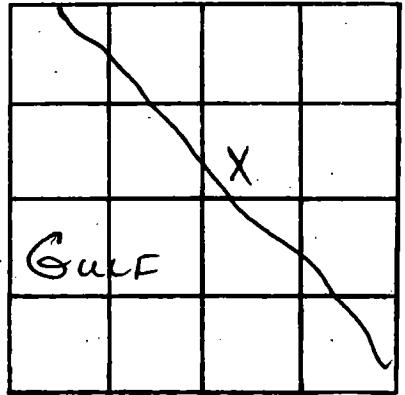

SECTION 10

Please indicate well location X.

ADDITIONAL INFORMATION

If more than one screen,
show locations of each on sketch.